## RECEIVED FEB 1 8 1994 CLARE COUNTY REMONUMENTATION PROGRAM [] | [] A []

COMMISSION

## LAND CORNER RECORDATION CERTIFICATE Filing Requirement of Act 74, Mich. P.A. 1970

1993 DEC 20 PM 1: 49

		٠
For	corners	ın

CLARE (County)		Located In:	Corner Code ##	
1.	Public Land Survey	T 19N R 4W	E-11	
		Ť R		
		TR		
		T R		
2.	Property Controlling	\$ T R		
	in Section	S		
3.	Miscellaneous	S T R		
	Property in Sec.	S T R		_

REGISTER OF DEEDS CLARE COUNTY DONNA M. CARR


Register of Deeds Stamp & File Number

4.	Lot No , F	Recorded Plat	
ō.	Private Claims		

NOVEMBER MARK R. ROBISON in a field survey on do hereby certify that under requirements of P.A. 74, Michigan P.A. of 1970, the corner points mentioned in lines 1 and 2 above were in conformance with regulations and rules therefore as required in the current manual of survey instructions of the United States Department of the Interior, Bureau of Land Management or by a decree of a Court of Law and/or that the corner points mentioned in lines 3, 4 and 5 above were in conformance with the rules of the Michigan Board of Land Surveyors or by a Decree of a Court of Law; established, re-established, monumented, re-monumented, recovered, found as expressed below:

NOTE: Not more than 4 corners, all in the same town and range, may be recorded on this certificate.

Description of original monument and accessories and/or subsequent restoration: 1856 G.E. ADAIR P.381 W.OAK 14, N55E 181KS, W.GAK 15, SISW 10 IKS. 11-18-76 URBANIAK, FOUND 5/8" ROD, SET CONC. MON. (132) 2-192 1-6-77 LAPHAM, LCRC 270-77 9-22-79 SEDGMAN, (132) 2-580 10-15-79 SEDGMAN, LCRC 346-79

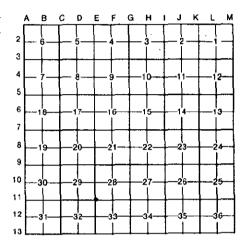


B. Description of corner evidence found and/or method applied in restoring or reestablishing corner:

FOUND CONC. MONUMENT FOUND RECORDED WITNESSES: NORTH, 2.6 - 18" OAK NE, 9.0' - 10" OAK S 30°E, 39.91' - 18" OAK S 10°W, 43.81' - 12" OAK

FOUND CONCRETE MONUMENT AND ALL WITNESSES. MONUMENT IN 4" DIA.  $\times$  36" LONG WITH 1/2" RE-BAR IN CENTER, DECISION WAS MADE TO LEAVE MONUMENT IN PLACE. WE WILL NOT REPLACE WITH STANDARD COUNTY

This Corner established in Clare County Remonumentation Program. See dossier for detailed report.

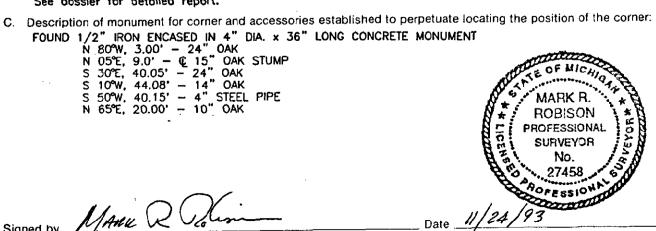

Signed by MANK Surveyor's Michigan License No. \_

\_ Date ..

FORM APPROVED BY MICHIGAN STATE BOARD OF LAND SURVEYORS, JAN. 28, 1971

REVISED JAN., 1983