

FEB 18 1994

CLARE COUNTY REMONUMENTATION PROGRAM

COMMISSION

LAND CORNER RECORDATION CERTIFICATE  
Filing Requirement of Act 74, Mich. P.A. 1970

1993 DEC 20 PM 1:48

For corners in

REGISTER OF DEEDS  
CLARE COUNTY  
DONNA M. CARR

CLARE (County)	Located In:	Corner Code #
1. Public Land Survey	T 19N R 4W	F-7
	T R	
	T R	
	T R	
2. Property Controlling in Section	S T R	
	S T R	
3. Miscellaneous Property in Sec.	S T R	
	S T R	

Register of Deeds Stamp & File Number

- 4. Lot No. \_\_\_\_\_, Recorded Plat \_\_\_\_\_
- 5. Private Claims \_\_\_\_\_

	A	B	C	D	E	F	G	H	I	J	K	L	M
2	6	5	4	3	2	1							
3													
4	7	8	9	10	11	12							
5													
6	18	17	16	15	14	13							
7													
8	19	20	21	22	23	24							
9													
10	30	29	28	27	26	25							
11													
12	31	32	33	34	35	36							
13													

I, MARK R. ROBISON, in a field survey on NOVEMBER, 19 93, do hereby certify that under requirements of P.A. 74, Michigan P.A. of 1970, the corner points mentioned in lines 1 and 2 above were in conformance with regulations and rules therefore as required in the current manual of survey instructions of the United States Department of the Interior, Bureau of Land Management or by a decree of a Court of Law and/or that the corner points mentioned in lines 3, 4 and 5 above were in conformance with the rules of the Michigan Board of Land Surveyors or by a Decree of a Court of Law; established, re-established, monumented, re-monumented, recovered, found as expressed below:


**NOTE: Not more than 4 corners, all in the same town and range, may be recorded on this certificate.**

A. Description of original monument and accessories and/or subsequent restoration:  
1856 G.E. ADAIR, Y. PINE 15" N 40-1/2°E, 48 LKS P. 358  
W. PINE 18" S 40-1/2°W, 44 LKS  
3-31-76 SEDGMAN, FOUND R.R. SPIKE, LCRC 233-76

B. Description of corner evidence found and/or method applied in restoring or reestablishing corner:  
FOUND R.R. SPIKE OVER 5/8" x 24" RE-BAR (BADLY RUSTED) UNDER ASPHALT PAVEMENT. EXCAVATED TO 36" DEPTH, FOUND NO OTHER EVIDENCE OF CORNER.  
FOUND RECORDED WITNESSES:  
NORTH, 31.93' - POWER POLE  
N 55°W, 64.22' - 10" OAK  
S 10°E, 45.00' - 18" OAK

This Corner established in Clare County Remonumentation Program.  
See dossier for detailed report.

C. Description of monument for corner and accessories established to perpetuate locating the position of the corner:  
SET 5/8" X 36" RE-ROD WITH 3" CLARE COUNTY MONUMENT CAP.  
NORTH 31.96' - POWER POLE  
N 55°W, 64.25' - 10" OAK  
S 10°E, 44.56' - 26" OAK  
S 65°W, 58.82' - 6" PINE

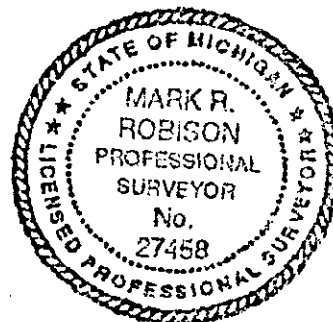

Signed by Mark R. Robison  
Surveyor's Michigan License No. 27458

Date 11/24/93