

RECEIVED

FEB 1 8 1994 CLARE COUNTY REMONUMENTATION PROGRAME IN A INC.


LAND CORNER RECORDATION CERTIFICATE

1993 DEC 20 PH 1: 48

For corners in	Filing Require	ement of Act 74, Mich. P	P.A. 1970	REGI	STER	ar.	DEF	nc.	
CLARE (County)	Located In:	Corner Code ##		CL	ARE VNA	נוממ	MTY	,	
1. Public Land Survey		G-9	V w ₁						, - \
	T R S T R S T R	<u></u>							
3. Miscellaneous S	S T R S T R		Register o	f Deeds	Stamp) & F	ile N	umbe)r
4. Lot No, Reco	rded Plat					•			
5. Private Claims			2 3	55-	-	G	H	_2_	
I,, MARK R. ROBISON , in	a field survey onNOVEMBE	<u>. 19</u> 93	4	, <u> </u> 8-	9-	+1	0	_[_11	_ 12-
do hereby certify that under requirer in lines 1 and 2 above were in con- current manual of survey instruction	ntormance with regulations and	d rules therefore as required i	in the " 1	917	16-	1	5	_14 	.—13- ∐
Management or by a decree of a Cou									T

Description of original monument and accessories and/or subsequent restoration: 1856 G.E. ADAIR, POST, W. PINE 14" N 74°W, 35 LKS P. 370 W. PINE 14" S 15°E, 35 LKS 9-7-13 A. JOHNSON, BIRCH 7" WEST, 38 LKS CSR 1-31 SPRUCE 5" S 81°W, 13 LKS 9-55 W. MOORE, OAK 14" S 84°W, 27.65' CSR 3-42 OAK 12" N 49°45'E, 46.35' 8-9-71 CAVANAGH, R.R. SPIKE & 4 WITNESSES (132) 1-23 5-5-72 LAPHAM, LCRC 31-72 11-29-76 SEDGMAN, LCRC 258-76

NOTE: Not more than 4 corners, all in the same town and range, may be recorded

above were in conformance with the rules of the Michigan Board of Land Surveyors or by a Decree of a Court of Law; established, re-established, monumented, re-monumented, recovered, found as

expressed below:

on this certificate.

B. Description of corner evidence found and/or method applied in restoring or reestablishing corner:

FOUND 1" x 6" BOLT OVER 1" x 18" IRON BAR (VERY RUSTED) IN MON. BOX IN ASPHALT PAVEMENT.

FOUND RECORDED WITNESSES:


WEST, 27.6' - 18" OAK

N 30°E, 35.8' - POWER POLE

MEASURED FROM PLAT OF DANCERS SUBDIVISION NO. 2 BACK TO SECTION CORNER, FOUND MONUMENT IS 0.5' EAST OF SECTION CORNER AS THUS RE-ESTABLISHED. ACCEPTED MONUMENT IN MON. BOX AS BEST EVIDENCE OF LOCATION OF CORNER.

This Corner established in Clare County Remonumentation Program. See dossier for detailed report.

27458

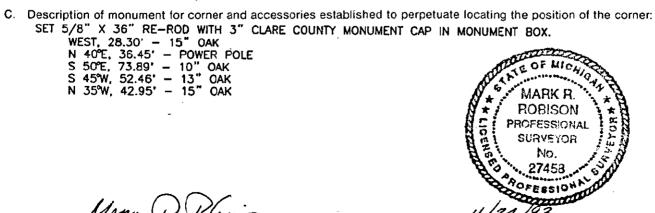

10

Signed by	MANU	Ω	Polision
- 5,			

Date