

SURVEY & REMONUMENTATION

JAN 23 2001.

SECTION LAND CORNER RECORDATION CERTIFICATE
Filing Requirement of Act 74, Mich. P.A. 1970
Clare County Remonumentation

For Corners in
Clare

(County)

Located In:

Corner Code#:

- 1. Public Land Survey T. 18N R. 4W G-1
 T. 19N R. 4W G-13 ✓
 T. _____ R. _____
- 2. Public Controlling S. _____ T. _____ R. _____
 in Section S. _____ T. _____ R. _____
- 3. Miscellaneous S. _____ T. _____ R. _____
 Property in Section S. _____ T. _____ R. _____
- 4. Lot No. _____, Recorded Plat _____
- 5. Private Claims _____

200000009277
 Filed for Record in
 CLARE COUNTY MICHIGAN
 CAROL MCAULAY
 On 11-14-2000 At 11:04 am.
 LAND CORNER 9.00
 OR Liber 2 Page 203 - 203

Instrument 200000009277 OR Liber Page 2 203

#408-00

Register of Deeds Stamp & File Number

I, Mark R. Robison, in a field survey on May 9, 2000, do hereby certify that under requirements of P.A. 74, Michigan P.A. of 1970, the corner points mentioned in lines 1 and 2 above were in conformance with regulations and rules therefore as required in the current manual of survey instructions of the United States Department of the Interior, Bureau of Land Management or by a decree of a Court of Law and/or that the corner points mentioned in lines 3, 4 and 5 above were in conformance with the rules of the Michigan Board of Land Surveyors or by a Decree of a Court of Law, established, re-established, monumented, re-monumented, recovered, found as expressed below.

NOTE: Not more than 2 corners, all in the same town and range, may be recorded on this certificate.

This is a single corner common to T18N, R4W, & T19N, R4W.

	A	B	C	D	E	F	G	H	I	J	K	L	M
2	6	5	4	3	2	1							
3													
4	7	8	9	10	11	12							
5													
6	18	17	16	15	14	13							
7													
8	19	20	21	22	23	24							
9													
10	30	29	28	27	26	25							
11													
12	31	32	33	34	35	36							
13													

A. Description of original monument and accessories and/or subsequent restoration:

- GLO
 Nicholson, 1838
 W. Oak 18" N80°W, 12 LINKS
 Pine 24" N40°E, 07 LINKS
 Survey, Batzer, 1975, L1. Pg. 937
 Same as LCRC #51-72
 G-1 to F-1 = 2656.12
- GLO
 Cannon, 1856
 W. Pine 38" S39°E, 48 LINKS
 W. Pine 14" S75°W, 14 LINKS
 Survey, Sedgman, 1977, L2. Pg. 331
 Same as LCRC #51-72
 G-1 to F-1 = 2656.45
- LCRC, Batzer, 1972, #51-72
 Fd tie rod as set by MSHD
 3 witnesses
 Survey, Lapham, 1981, L2. Pg. 664
 Same as LCRC #51-72
- LCRC, Lapham, 1972, #52-72
 3 witnesses same as LCRC #51-72
 Survey, Lapham, 1989 L3. Pg. 161
 Same as LCRC #51-72

APPROVED LAND CORNER
 P.A. 345 of 1990
 Clare County


Chairman Paul S. Lapp
 Date 8-30-00

B. Description of corner evidence found and/or method applied in restoring or re-establishing corner.

No GLO evidence found. Found tie rod, 1 OBT from LCRC #51-72 and old stump remains of 2 OBT'S for LCRC #51-72. Distance G-1 to F-1 measured as 2656.12. Accepted tie rod as best available evidence of the accepted position of the corner.

C. Description of monument for corner and accessories established to perpetuate locating the position of the corner:

- Set 5/8" x 36" rerod with Clare County Remon Cap marked P.S. #27458.
- Witnesses:
 S67°W, 4.63' - N & T in 13" Pin Oak (OBT)
 S10°W, 14.33' - N & T in 12" Pin Oak
 East, 27.56' - N & T in 15" Pin Oak
 N27°E, 19.64' - N & T in 6" Maple

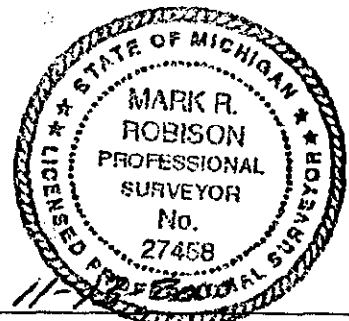

Signed by Mark R. Robison
 Surveyor's Michigan License No. 27458

Date 11-14-00