

**SURVEY &  
REMONUMENTATION**

**JAN 23 2001**

**SECTION**

**LAND CORNER RECORDATION CERTIFICATE  
Filing Requirement of Act 74, Mich. P.A. 1970  
Clare County Remonumentation**

For Corners in  
Clare

(County)

Located In:

Corner Code#:

- |                                       |                            |               |
|---------------------------------------|----------------------------|---------------|
| 1. Public Land Survey                 | T. <u>19N</u> R. <u>4W</u> | <u>I-13</u> ✓ |
|                                       | T. <u>18N</u> R. <u>4W</u> | <u>I-1</u>    |
|                                       | T. _____ R. _____          | _____         |
| 2. Public Controlling in Section      | S. _____ T. _____ R. _____ | _____         |
|                                       | S. _____ T. _____ R. _____ | _____         |
| 3. Miscellaneous Property in Section  | S. _____ T. _____ R. _____ | _____         |
| 4. Lot No. _____, Recorded Plat _____ |                            |               |
| 5. Private Claims _____               |                            |               |

200000009279  
Filed for Record in  
CLARE COUNTY MICHIGAN  
CAROL MCAULAY  
On 11-14-2000 At 11:04 am.  
LAND CORNER 9.00  
OR Liber 2 Page 205 - 205

Instrument 200000009279 OR Liber Page 2 205

# 410-00

Register of Deeds Stamp & File Number

I, Mark R. Robison, in a field survey on May 9, 2000, do hereby certify that under requirements of P.A. 74, Michigan P.A. of 1970, the corner points mentioned in lines 1 and 2 above were in conformance with regulations and rules therefore as required in the current manual of survey instructions of the United States Department of the Interior, Bureau of Land Management or by a decree of a Court of Law and/or that the corner points mentioned in lines 3, 4 and 5 above were in conformance with the rules of the Michigan Board of Land Surveyors or by a Decree of a Court of Law, established, re-established, monumented, re-monumented, recovered, found as expressed below.

**NOTE: Not more than 2 corners, all in the same town and range, may be recorded on this certificate.**

This is a single common corner to T19N, R4W, & T18N, R4W.

**A. Description of original monument and accessories and/or subsequent restoration:**

GLO  
Nicholson, 1838  
Cedar 15" N34°E, 39 LINKS  
Pine 22" N43°W,

C.S.R.  
Unknown, Circa 1900 Bk. 6 Pg. 183  
W. Pine 20" S21 1/2°W 38 LINKS

Survey, Sedgman, 1978, L2. Pg. 359  
Same as LCRC #230-76

GLO  
Cannon, 1856  
W. Pine 30" S58°W, 57 LINKS  
W. Pine 23" S70°E, 38 LINKS

LCRC, Sedgman, 1975, #230-76  
Found 5/8" bar, 3 witnesses

Private Files - Lapham, 1975  
I-1 to J-1 = 2643.92

C.S.R.  
Moore, 1956, Bk. 3 Pg. 47  
Iron in pavement at intersection of centerlines  
I-1 to J-1 = 2643.8

Survey, Sedgman, 1975, L2. Pg. 107  
Same as LCRC #230-76

**APPROVED LAND CORNER  
P.A. 345 of 1990  
Clare County**


Chairman *Paul L. Lapham*  
Date 8-30-00

**B. Description of corner evidence found and/or method applied in restoring or re-establishing corner.**

No GLO evidence found. Found 5/8" x 18" rerod in Mon. Box and 3 LCRC witnesses. Irons position matches 1956 CSR call closely. Currently 1.4' South of centerline M-61, 6' East of trail North and on centerline of old grade south. 1956 CSR matches 1975 distances. Meas. West 2634.74 to H-1 and East 2643.92 to J-1. Accepted found iron as best available evidence of the accepted position of the corner.

**C. Description of monument for corner and accessories established to perpetuate locating the position of the corner:**

Set 5/8" x 36" rerod in Mon. Box with Clare County Remon Cap marked P.S. #27458.  
Witnesses:  
S50°E, 76.05' - N & T in 10" Cedar (OBT)  
N30°E, 67.88' - N & T in 10" Cedar (OBT)  
N34°W, 66.13' - N & T in 10" x 14" Cedar (OBT)  
S24°W, 81.78' - Center of concrete R/W marker

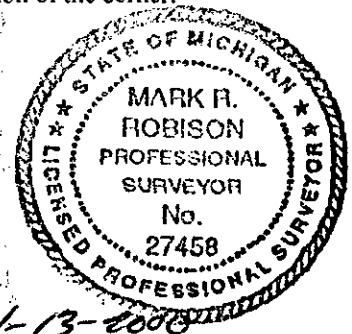

Signed by *Mark R. Robison*  
Surveyor's Michigan License No. 27458

Date 11-13-2000