

**SURVEY &
REMONUMENTATION**

JAN 23 2001

SECTION

LAND CORNER RECORDATION CERTIFICATE
Filing Requirement of Act 74, Mich. P.A. 1970
Clare County Remonumentation

For Corners in
Clare

200000009280
 Filed for Record in
 CLARE COUNTY MICHIGAN
 CAROL MCAULAY
 On 11-14-2000 At 11:04 am.
 LAND CORNER 9.00
 OR Liber 2 Page 206 - 206

(County)	Located In:	Corner Code#:
1. Public Land Survey	T. <u>19N</u> R. <u>4W</u>	<u>J-13</u> ✓
	T. <u>18N</u> R. <u>4W</u>	<u>J-1</u>
	T. _____ R. _____	_____
2. Public Controlling in Section	S. _____ T. _____ R. _____	_____
	S. _____ T. _____ R. _____	_____
3. Miscellaneous Property in Section	S. _____ T. _____ R. _____	_____
	S. _____ T. _____ R. _____	_____
4. Lot No. _____, Recorded Plat _____		
5. Private Claims _____		

Instrument Liber Page
 200000009280 OR 2 206

#411-00

Register of Deeds Stamp & File Number

I, Mark R. Robison, in a field survey on May 9, 2000, do hereby certify that under requirements of P.A. 74, Michigan P.A. of 1970, the corner points mentioned in lines 1 and 2 above were in conformance with regulations and rules therefore as required in the current manual of survey instructions of the United States Department of the Interior, Bureau of Land Management or by a decree of a Court of Law and/or that the corner points mentioned in lines 3, 4 and 5 above were in conformance with the rules of the Michigan Board of Land Surveyors or by a Decree of a Court of Law, established, re-established, monumented, re-monumented, recovered, found as expressed below.

	A	B	C	D	E	F	G	H	I	J	K	L	M
2	6	5	4	3	2	1							
3													
4	7	8	9	10	11	12							
5													
6	18	17	16	15	14	13							
7													
8	19	20	21	22	23	24							
9													
10	30	29	28	27	26	25							
11													
12	31	32	33	34	35	36							
13													

NOTE: Not more than 2 corners, all in the same town and range, may be recorded on this certificate.

This is a single corner common T18N, R4W. & T19N, R4W.

A. Description of original monument and accessories and/or subsequent restoration:

GLO
 Nicholson, 1838
 15" Cedar for corner

C.S.R.
 Moore, 1958, Bk. 3 Pg. 47 & 93
 Corner per sketch in book
 Set monument 75'
 South of centerline
 I-1 to J-1 = 2643.8
 J-1 to K-1 = 2643.8

LCRC
 Sedgman, 1975 #230-76
 Found spike, reset 1/2" capped bar
 3 witnesses

Private Files - Lapham, 1975
 I-1 to J-1 = 2643.92
 J-1 to K-1 = 2643.78

APPROVED LAND CORNER
 P.A. 345 of 1990
 Clare County


Chairman Paul S. Lapham
 Date 8-30-00

B. Description of corner evidence found and/or method applied in restoring or re-establishing corner:

No GLO evidence found. Found 1/2" x 18" capped iron in Mon. Box in centerline of M-61. New guard rails placed so all 1975 witnesses are gone. No other evidence of corners found. 1958 CSR matches with 1975 Lapham measurements and current measurements, measured West 2643.92 to I-1 & East 2643.78 to K-1. Accept found iron as best available evidence accepted position of the corner.

C. Description of monument for corner and accessories established to perpetuate locating the position of the corner:

Set 5/8" x 36" rerod in Mon. Box with Clare County Remon Cap marked P.S. #27458.
 Witnesses:
 N45°E, 30.42' - N & T in top of guard rail post
 North, 20.96' - N & T in top of guard rail post
 N45°W, 25.52' - N & T in top of guard rail post
 S55°E, 102.80' - 1/2" Iron

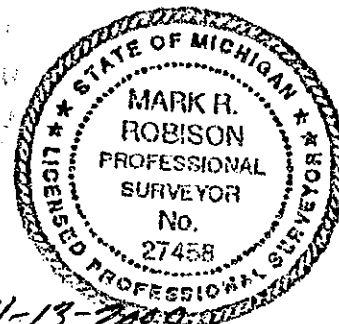

Signed by Mark R. Robison
 Surveyor's Michigan License No. 27458

Date 11-13-2000