

**LAND CORNER RECORDATION CERTIFICATE**  
 Filing Requirement of Act 74, Mich. P.A. 1970

For corners in

<u>CLARE</u> (County)	Located In:	Corner Code #
1. Public Land Survey	T <u>19N</u> R <u>4W</u>	<u>K-7</u>
	T <u>    </u> R <u>    </u>	<u>    </u>
	T <u>    </u> R <u>    </u>	<u>    </u>
	T <u>    </u> R <u>    </u>	<u>    </u>
2. Property Controlling in Section	S <u>    </u> T <u>    </u> R <u>    </u>	<u>    </u>
	S <u>    </u> T <u>    </u> R <u>    </u>	<u>    </u>
3. Miscellaneous Property in Sec.	S <u>    </u> T <u>    </u> R <u>    </u>	<u>    </u>
	S <u>    </u> T <u>    </u> R <u>    </u>	<u>    </u>

RECEIVED  
 #159-96  
 96 NOV 14 PM 4:16  
 REGISTER OF DEEDS  
 CLARE COUNTY  
 DONALD M. LARF  
 Register of Deeds Stamp & File Number

4. Lot No. \_\_\_\_\_, Recorded Plat \_\_\_\_\_  
 5. Private Claims \_\_\_\_\_

I, MARK R. ROBISON, in a field survey on AUGUST, 1996 do hereby state that under requirements of P.A. 74, Michigan P.A. of 1970, the corner points mentioned in lines 1 and 2 above were in conformance with regulations and rules therefore as required in the current manual of survey instructions of the United States Department of the Interior, Bureau of Land Management or by a decree of a Court of Law and /or that the corner points mentioned in lines 3, 4 and 5 above were in conformance with the rules of the Michigan Board of Land Surveyors or by a Decree of a Court of Law; established, re-established, monumented, recovered, found as expressed below:

1	A	B	C	D	E	F	G	H	I	J	K	L
2	6		5		4		3		2		1	
3												
4	7		8		9		10		11		12	
5												
6	18		17		16		15		14		13	
7												
8	19		20		21		22		23		24	
9												
10	30		29		28		27		26		25	
11												
12	31		32		33		34		35		36	
13												

NOTE: Not more than 2 corners, all in the same town and range, may be recorded on this certificate.

A. Description of original monument and accessories and/or subsequent restoration:

1857 ADAIR  
 WIT.-SET POST  
 W. PINE 26" N77°W, 24 LKS.  
 W. OAK 19" S36 1/2°E 84 LKS.  
 UNDATED UNKNOWN, (C.S.R.) L.5, PG. 229  
 WIT.-K-7 TO L-7, 39.75'  
 K-7 TO M-7, 79.50'  
 07-09-56 MOORE  
 WIT.-S.E. COR. OF SEC. 14 COULDN'T BE FOUND.  
 MEASURED FROM S.W. COR. 14 TO S.E. COR OF 13  
 FOR DISTANCE OF 10520 FT. PLACED S.E. COR. 14  
 AT 5260'.

1966 LAPHAM  
 WIT.-SCENIC HILLS SUBD.  
 10-3-73 SEDGMAN, (132) L.1, PG. 598  
 WIT.-FOUND 1/2" PIPE.  
 S05°E, 75.07' - POWER POLE.  
 S35°W, 69.37' - 12" PEAR TREE.  
 N05°E, 165.40' - POWER POLE.  
 11-06-73 LAPHAM L.C.R.C. #122  
 WIT.-FOUND 1/2" PIPE.  
 SAME WITNESSES AS 10-03-73  
 06-25-74 LAPHAM, (132) L.1, PG. 737  
 WIT.-REFERENCES L.C.R.C. #122

08-01-74 McCLUNG, L.C.R.C. #195  
 WIT.-SET 33' NORTH OF PLAT MON.  
 10-18-76 SEDGMAN, (132) L.2, PG.  
 WIT.-FOUND 1/2" PIPE  
 SAME WITNESSES AS 10-03-73  
 10-28-83 LAPHAM, (132) L.2, PG.  
 WIT.-FOUND 1/2" PIPE  
 SAME WITNESSES AS 10-03-73.  
 11-09-83 LAPHAM, (132) L.2 PG. 8  
 WIT.-SAME AS 10-03-73

B. Description of corner evidence found and/or method applied in restoring or reestablishing corner:

FOUND 1/2"x18" PIPE. EXCAVATED TO 3 FEET. FOUND NO OTHER EVIDENCE. FOUND 1973 WITNESSES.

See dossier for detailed report.


C. Description of monument for corner and accessories established to perpetuate locating the position of the corner:

SET 5/8"x36' RE-ROD WITH 3" CLARE COUNTY MONUMENT CAP.  
 ACCEPTED AS BEST AVAILABLE EVIDENCE OF THE ACCEPTED POSITION OF THE CORNER.

WITNESSES:  
 S05°E, 75.07' - NAIL & TAG IN POWER POLE (OBT).  
 S31°W, 69.37' - NAIL & TAG IN 21" PEAR TREE (OBT).  
 N05°E 165.40' - NAIL & TAG IN POWER POLE (OBT).  
 S32°E, 119.96' - N.W. CORNER F.O.E. BLDG.

APPROVED LAND CORNER  
 P.A. 345 of 1990  
 Clare County  
 Chairman Paul A. Lapham  
 Date 11-07-96

Signed by Mark R. Robison  
 Surveyor's Michigan License No. 27458

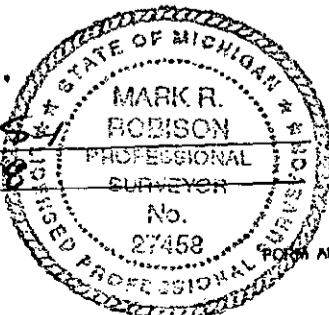

Date 9-23-96