

SURVEY & REMONUMENTATION

JAN 23 2001

SECTION LAND CORNER RECORDATION CERTIFICATE
Filing Requirement of Act 74, Mich. P.A. 1970
Clare County Remonumentation

For Corners in <u>Clare</u> (County)	Located In:	Corner Code#:
1. Public Land Survey	T. <u>19N</u> R. <u>4W</u>	<u>K-13</u> ✓
	T. <u>18N</u> R. <u>4W</u>	<u>K-1</u>
	T. _____ R. _____	_____
2. Public Controlling in Section	S. _____ T. _____ R. _____	_____
	S. _____ T. _____ R. _____	_____
3. Miscellaneous Property in Section	S. _____ T. _____ R. _____	_____
	S. _____ T. _____ R. _____	_____
4. Lot No. _____, Recorded Plat _____		
5. Private Claims _____		

200000009281
 Filed for Record in
 CLARE COUNTY MICHIGAN
 CAROL MCAULAY
 On 11-14-2000 At 11:04 am.
 LAND CORNER 9.00
 OR Liber 2 Page 207 - 207

Instrument Liber Page
 200000009281 OR 2 207

#412-00

Register of Deeds Stamp & File Number

I, Mark R. Robison, in a field survey on May 9, 2000, do hereby certify that under requirements of P.A. 74, Michigan P.A. of 1970, the corner points mentioned in lines 1 and 2 above were in conformance with regulations and rules therefore as required in the current manual of survey instructions of the United States Department of the Interior, Bureau of Land Management or by a decree of a Court of Law and/or that the corner points mentioned in lines 3, 4 and 5 above were in conformance with the rules of the Michigan Board of Land Surveyors or by a Decree of a Court of Law, established, re-established, monumented, re-monumented, recovered, found as expressed below.

	A	B	C	D	E	F	G	H	I	J	K	L	M
2	6	5	4	3	2	1							
3													
4	7	8	9	10	11	12							
5													
6	18	17	16	15	14	13							
7													
8	19	20	21	22	23	24							
9													
10	30	29	28	27	26	25							
11													
12	31	32	33	34	35	36							
13													

NOTE: Not more than 2 corners, all in the same town and range, may be recorded on this certificate.

This is a single corner common to T19N, R4W, & T18N, R4W.

A. Description of original monument and accessories and/or subsequent restoration:

GLO
 Nicholson, 1838
 Cedar 10" N64 1/2°W 53 LINKS
 Elm 4" N30°E, 21 LINKS

C.S.R.
 Moore, 1958, Bk. 3 Pg. 93
 Found corner per sketch
 373.9' North of centerline along section line

LCRC
 Carter, 1996, #802-96
 Found concrete monument 4' deep and
 1-1990 witness
 Set 3/4" rerod with 1-OBT and 3-NBT

GLO
 Cannon, 1856
 Elm 7" S72 1/2°E, no links
 B. Ash 16" S10°W, 38 LINKS

Survey
 Fluharty, 1990 L3. Pg. 256
 Found concrete monument, 4 witnesses

APPROVED LAND CORNER
 P.A. 345 of 1990
 Clare County

C.S.R.
 Moore, 1956, Bk. 3 Pg. 47
 Found corner per sketch

Survey
 Fluharty, 1990, L3. Pg. 258
 Same as survey 3-256

Chairman David L. Poppe
 Date 1-30-00


B. Description of corner evidence found and/or method applied in restoring or re-establishing corner:

No GLO evidence found. Found 3/4" rerod and 3-1996 witnesses. Dug to 4' deep and found concrete monument lying 372' +/- North of centerline M-61. Measured to L-1 as 2631.75'. Accepted found rerod and monument as best available evidence accepted position of the corner.

C. Description of monument for corner and accessories established to perpetuate locating the position of the corner:

Set 5/8" x 36" rerod with Clare County Remon Cap marked P.S. #27458 over found concrete monument.

Witnesses:
 S56°W, 102.70' - N & T in 16" x 14" Maple (OBT)
 N17°E, 60.24' - N & T in Maple Clump (OBT)
 S45°E, 11.25' - N & T in 7" Basswood
 S10°W, 16.25' - N & T in 12" Basswood
 S80°W, 54.5' - N.E. Corner of pipe bridge rail (OBT)

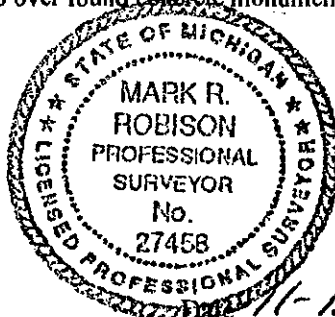

Signed by Mark R. Robison
 Surveyor's Michigan License No. 27458