

**SURVEY &  
REMONUMENTATION**

**JAN 23 2001**

**LAND CORNER RECORDATION CERTIFICATE**

**SECTION**

**Filing Requirement of Act 74, Mich. P.A. 1970**

**Clare County Remonumentation 0000009282**

Filed for Record in  
CLARE COUNTY MICHIGAN  
CAROL MCAULAY  
On 11-14-2000 At 11:04 am.  
LAND CORNER 9.00  
OR Liber 2 Page 208 - 208

For Corners in

Clare (County)	Located In:	Corner Code#:
1. Public Land Survey	T. <u>18N</u> R. <u>4W</u>	<u>L-1</u>
	T. <u>19N</u> R. <u>4W</u>	<u>L-13</u> ✓
	T. _____ R. _____	_____
2. Public Controlling in Section	S. _____ T. _____ R. _____	_____
	S. _____ T. _____ R. _____	_____
3. Miscellaneous Property in Section	S. _____ T. _____ R. _____	_____
	S. _____ T. _____ R. _____	_____
4. Lot No. _____, Recorded Plat		
5. Private Claims		

Instrument Liber Page  
20000009282 OR 2 208

#413-00

Register of Deeds Stamp & File Number

I, Mark R. Robison, in a field survey on May 9, 2000, do hereby certify that under requirements of P.A. 74, Michigan P.A. of 1970, the corner points mentioned in lines 1 and 2 above were in conformance with regulations and rules therefore as required in the current manual of survey instructions of the United States Department of the Interior, Bureau of Land Management or by a decree of a Court of Law and/or that the corner points mentioned in lines 3, 4 and 5 above were in conformance with the rules of the Michigan Board of Land Surveyors or by a Decree of a Court of Law, established, re-established, monumented, re-monumented, recovered, found as expressed below.

**NOTE: Not more than 2 corners, all in the same town and range, may be recorded on this certificate.**

This is a single corner common to T18N, R4W & T19N, R4W

A. Description of original monument and accessories and/or subsequent restoration:

GLO  
Nicholson, 1838 Survey, Fluharty, 1990 L3. Pg. 258  
Beech 7" N67°E, 28 LINKS Same as 3-256  
Birch 6" N8°W, 27 LINKS  
  
Survey, Fluharty, 1990 L3. Pg. 256  
Set 5/8" iron, 4 witnesses  
Set by SPM at 2631.75 each way

APPROVED LAND CORNER  
P.A. 345 of 1990  
Clare County


Chairman *Paul S. Loph*  
Date 8-30-00

B. Description of corner evidence found and/or method applied in restoring or re-establishing corner:

No GLO evidence found. Found 5/8" x 20" rered with cap at 2631.75' from K-1 to L-1 & M-1 to L-1. Excavated to a depth of 1.5' and nothing else found. Found 4 witnesses from 1990 surveys. Accepted found iron as best available evidence of accepted position of the corner.

C. Description of monument for corner and accessories established to perpetuate locating the position of the corner:  
Set 5/8" x 36" rered with Clare County Remon Cap marked P.S. #27458.

Witnesses:  
S85°W, 75' - N & T 40" x 36" R. Oak (OBT)  
N37°W, 26.08' - N & T 15" x 25" R. Oak (OBT)  
N10°E, 27.35' - N & T 12" R. Oak (OBT)  
S25°W, 56.11' - N/W Corner Blk Foundation of Hse (OBT)  
East, 21.14' - Capped Iron #18223 (Property corner per L-3, Pg. 258)

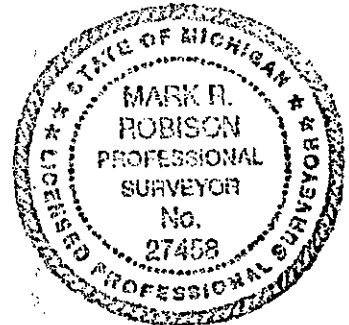

Signed by *Mark R. Robison*

Date 11-13-2000

Surveyor's Michigan License No. 27458