

**SURVEY &
REMONUMENTATION**

JAN 23 2001

SECTION

LAND CORNER RECORDATION CERTIFICATE
Filing Requirement of Act 74, Mich. P.A. 1970
Clare County Remonumentation

For Corners in
Clare

(County)

Located In:

Corner Code#:

- | | | |
|---|----------------------------|------------|
| 1. Public Land Survey | T. <u>20N</u> R. <u>3W</u> | <u>B-7</u> |
| | T. _____ R. _____ | _____ |
| | T. _____ R. _____ | _____ |
| 2. Public Controlling
in Section | S. _____ T. _____ R. _____ | _____ |
| | S. _____ T. _____ R. _____ | _____ |
| 3. Miscellaneous
Property in Section | S. _____ T. _____ R. _____ | _____ |
| | S. _____ T. _____ R. _____ | _____ |
| 4. Lot No. _____, Recorded Plat _____ | | |
| 5. Private Claims _____ | | |

200000009700
Filed for Record in
CLARE COUNTY MICHIGAN
CAROL MCAULAY
On 11-29-2000 At 10:31 am.
LAND CORNER 9.00
OR Liber 2 Page 230 - 230

Instrument Liber Page
200000009700 OR 2 230

435-00

Register of Decds Stamp & File Number

I, Mark R. Robison, in a field survey on March 15, 2000, do hereby certify that under requirements of P.A. 74, Michigan P.A. of 1970, the corner points mentioned in lines 1 and 2 above were in conformance with regulations and rules therefore as required in the current manual of survey instructions of the United States Department of the Interior, Bureau of Land Management or by a decree of a Court of Law and/or that the corner points mentioned in lines 3, 4 and 5 above were in conformance with the rules of the Michigan Board of Land Surveyors or by a Decree of a Court of Law, established, re-established, monumented, re-monumented, recovered, found as expressed below.

NOTE: Not more than 2 corners, all in the same town and range, may be recorded on this certificate.

	A	B	C	D	E	F	G	H	I	J	K	L	M
2	6	5	4	3	2	1							
3													
4	7	8	9	10	11	12							
5													
6	18	17	16	15	14	13							
7													
8	19	20	21	22	23	24							
9													
10	30	29	28	27	26	25							
11													
12	31	32	33	34	35	36							
13													

A. Description of original monument and accessories and/or subsequent restoration:

G.L.O. 1856 Adair Maple 5" N31°E, 20 LINKS Beech 5" S37 ½°W, 21 LINKS	Subdivision Plat Plat of "Browns Haven" Liber 4, Pg. 38
--	---

B. Description of corner evidence found and/or method applied in restoring or re-establishing corner:

Set at intersection of East line of Browns Haven extended North and a line between the (C-7) and Northwest Section Corners (A-7).
Concluded that GLO measured an extra chain in E1/2 of Section. Accepted as best available evidence of accepted position of the corner.

C. Description of monument for corner and accessories established to perpetuate locating the position of the corner:


Set 5/8" x 36" re-rod with Clare County Remon Cap marked P.S. #27458.

Witnesses:

S46°E, 11.6' - N & T Northeast side 15" R. Pine
S32°W, 22.92' - N & T Northeast side 6" x 6" x 6" x 4"
N86°W, 18.61' - N & T Northeast side 10" x 5" Twin Maple
N4°E, 26.69' - N & T East side 13" x 13" Twin Maple
S89-57-10W, 2713.45 Corner A-7 T20N, R3W
N89-57-10E, 2700.44 Corner B-7 T20N, R3W

APPROVED LAND CORNER
P.A. 345 of 1990
Clare County

Chairman Paul S. Leph
Date 5-10-90

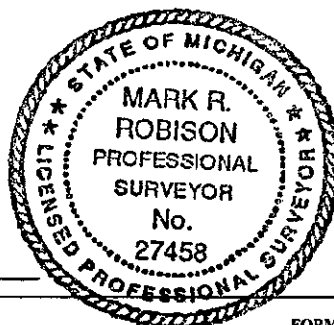

Signed by Mark R. Robison
Surveyor's Michigan License No. 27458

Date 11-28-2000