

Survey &  
REMONUMENTATION

CLARE COUNTY REMONUMENTATION

NOV 18 1997

LAND CORNER RECORDATION CERTIFICATE  
Filing Requirement of Act 74, Mich. P.A. 1970

For corners in **COMMISSION**

<u>CLARE</u> (County)	Located In:	Corner Code #
1. Public Land Survey	T 20N R 3W T 19N R 3W T _____ R _____ T _____ R _____	<u>B-13</u> B-1 _____ _____
2. Property Controlling in Section	S _____ T _____ R _____ S _____ T _____ R _____	_____ _____
3. Miscellaneous Property in Sec.	S _____ T _____ R _____ S _____ T _____ R _____	_____ _____

FRANKLIN  
HAMILTON

Register of Deeds Stamp & File Number

4. Lot No. \_\_\_\_\_, Recorded Plat \_\_\_\_\_  
5. Private Claims \_\_\_\_\_

I, **MARK R. ROBISON**, in a field survey on July 1, 19 97 do hereby state that under requirements of P.A. 74, Michigan P.A. of 1970, the corner points mentioned in lines 1 and 2 above were in conformance with regulations and rules therefore as required in the current manual of survey instructions of the United States Department of the Interior, Bureau of Land Management or by a decree of a Court of Law and for that the corner points mentioned in lines 3, 4 and 5 above were in conformance with the rules of the Michigan Board of Land Surveyors or by a Decree of a Court of Law; established, re-established, monumented, recovered, found as expressed below:

NOTE: Not more than 2 corners, all in the same town and range, may be recorded on this certificate.

A	B	C	D	E	F	G	H	I	J	K	L	M
1												
2	6		5		4		3		2		1	
3												
4	7		8		9		10		11		12	
5												
6	18		17		16		15		14		13	
7												
8	19		20		21		22		23		24	
9												
10	30		29		28		27		26		25	
11												
12	31		32		33		34		35		36	
13												

A. Description of original monument and accessories and/or subsequent restoration:  
 1838 Nicholson, Set Gr. Sec. Post  
 Beech 8 N72W 33, Hemlock 8 N74E 36  
 10/25/99 Harper CSR 1-1 & 4-1  
 Beech 8 N72W 33, Beech 8 S5E 67  
 Meas West 40.12 & East 38.04  
 11/04/07 Johnson CSR 4-126 & 5-78  
 Gray Stone (x), S61W 42 1/2  
 10/68 Meyers Set corner in un-recorded survey. Notes indicate corner set on fence line to North, 2582 feet East of Section corner with 1/8 line fences at mid point.  
 12/16/74 McClung LCRC 192 & (132) 1-921  
 Found spike, set 3/4" iron & cap  
 N05E 51.5 18" Maple, N45W 48.5 Ash  
 Meas West 2710.47 to Sec Cor  
 1/16/75 Lapham LCRC #183  
 Found MMC C.I., N45W 41.75 PP  
 N06E 47.00 12" Maple, S45E 40.60 Poplar  
 1/14/75 Meyers (132) 1-906 Same as LCRC  
 5/08/91 Robison (132) 3-331  
 Fd C.I. same witnesses as LCRC #192  
 12/09/93 G. Smith LCRC #752

Found 1/2" iron & cap in pipe 2' South of centerline road. Set 1/2" iron & cap N45W 40.8 PP, N14E 47.42 16" Maple S02E 52.03 24" Maple N00W 82.23 Twin 10" Maple, West 18.85 1/2" iron /cap N1/4 Sec 6, T19N, R3W 3/14/97 Robison Unrecorded Survey Found 1/2" iron, N05E 47.0 12" Maple N45W 41.75 PP, S05E 51.5 18" Maple N45W 48.5 Ash, Notes say cor in Mon Box

B. Description of corner evidence found and/or method applied in restoring or reestablishing corner:

Found 1/2" x 18" C.I. in Mon Box. Excavated but found no other material. Found 1974 witnesses, two 1975 witnesses, all 1993 and 1997 witnesses. This corner is common with the North 1/4 Corner of Section 6 per GLO notes and best fits proration of the CSR measurements. Arnold Lake Road underwent major reconstruction in the 1990's. Old corners destroyed during construction were to be perpetuated by Wilcox, County Engineer.

See dossier for detailed report.


APPROVED LAND CORNER  
P.A. 845 of 1990  
Clare County

Chairman Paul R. Taylor  
Date 9-23-97

C. Description of monument for corner and accessories established to perpetuate locating the position of the corner:

Set 5/8" x 36" rerod with Clare County Remonumentation Cap marked P.S.#27458 in Monument Box. Accepted as best available evidence of accepted position of corner.

Witnesses:  
 N05E 47.42 N & T in 12" Maple (OBT)  
 N45W 41.75 N & T in PP (OBT)  
 S04E 52.03 N & T in 25" Maple (OBT)  
 N60W 82.23 N & T in Twin 12" Maple (OBT)  
 West 18.75 1/2" iron in asphalt (OBT)

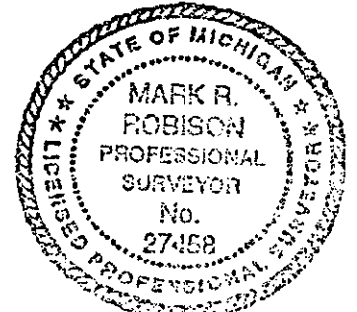

Signed by Mark R. Robison  
 Surveyor's Michigan License No. 27458

Date 10-01-97