

MAR 24 2000

SECTION

LAND CORNER RECORDATION CERTIFICATE  
Filing Requirement of Act 74, Mich. P.A. 1970  
Clare County Remonumentation

For Corners in  
Clare

(County)

Located In:

Corner Code#:

- |   |                            |            |
|---|----------------------------|------------|
| 1. Public Land Survey                   | T. <u>20N</u> R. <u>3W</u> | <u>C-9</u> |
|   | T. _____ R. _____          | _____      |
|   | T. _____ R. _____          | _____      |
| 2. Public Controlling<br>in Section     | S. _____ T. _____ R. _____ | _____      |
|   | S. _____ T. _____ R. _____ | _____      |
| 3. Miscellaneous<br>Property in Section | S. _____ T. _____ R. _____ | _____      |
|   | S. _____ T. _____ R. _____ | _____      |
| 4. Lot No. _____, Recorded Plat _____   |                            |            |
| 5. Private Claims _____                 |                            |            |

199900007857  
Filed for Record in  
CLARE COUNTY MICHIGAN  
CAROL MCAULAY  
On 09-20-1999 At 11:15 am.  
LAND CORNER 9.00  
OR Liber 2 Page 21 - 21

Instrument 199900007857 OR Liber 2 Page 21

Register of Deeds Stamp & File Number

I, Mark R. Robison, in a field survey on July 22, 1999, do hereby certify that under requirements of P.A. 74, Michigan P.A. of 1970, the corner points mentioned in lines 1 and 2 above were in conformance with regulations and rules therefore as required in the current manual of survey instructions of the United States Department of the Interior, Bureau of Land Management or by a decree of a Court of Law and/or that the corner points mentioned in lines 3, 4 and 5 above were in conformance with the rules of the Michigan Board of Land Surveyors or by a Decree of a Court of Law, established, re-established, monumented, re-monumented, recovered, found as expressed below.

NOTE: Not more than 2 corners, all in the same town and range, may be recorded on this certificate.

1	A	B	C	D	E	F	G	H	I	J	K	L	M
2	6	5	4	3	2	1							
3													
4	7	8	9	10	11	12							
5													
6	18	17	16	15	14	13							
7													
8	19	20	21	22	23	24							
9													
10	30	29	28	27	26	25							
11													
12	31	32	33	34	35	36							
13													

A. Description of original monument and accessories and/or subsequent restoration:

1856 Adair  
Set Post Cor Sec. 19-20-29-30  
Beech 8 N22 1/2 E60  
Beech 12 S60W 26

1912 Johnson, CSR 5-138  
W. Pine 40 N46W 21  
W. Pine 40 S23E 64  
Meas. West 39.70

1979 Lapham, (132) 2-459 & LCRC #364  
Fd 1/2" Pipe  
S45W 75.55 P.P.  
S45E 48.90 Fence Cor.  
North 20.00 Sign Post  
N30W 22.20 Cedar Post

1992 Geers, LCRC #735  
Fd & accepted 1/2" Pipe 3' below Grade  
Corner falls 2' South of center gravel  
road E-W. Raised w/ 1/2" rebar & cap  
N26W 49.10 6" Poplar  
N01E 46.31 8" Poplar  
N52E 75.35 10" Red Pine  
S51W 76.08 P.P.

APPROVED LAND CORNER  
P.A. 345 of 1990  
Clare County

Chairman *Mark R. Robison*  
Date 9-15-99

B. Description of corner evidence found and/or method applied in restoring or re-establishing corner:

See dossier for detailed report.


Found 1/2" x 18" re-rod in Mon. Box. Found one 1979 witness and four 1992 witnesses. Measured South 2640.63 to C-10. Meas. East 5339.10 to E-9.

C. Description of monument for corner and accessories established to perpetuate locating the position of the corner.

Set 5/8" x 36" re-rod with Clare Co. Remon Cap marked P.S. #27458 in Mon. Box. Accepted as best available evidence of the accepted position of the corner.

Witnesses:

N 44E 75.32 Fd N & T in 14" W. Pine (OBT)  
S56E 54.27 Set N & T in Cor. F. Post  
S64W 75.83 Fd spike in P.P. (OBT)  
N33W 49.10 Set N & T in 12" Poplar (OBT)  
N07W 46.00 C.L. of 14" Poplar (OBT)

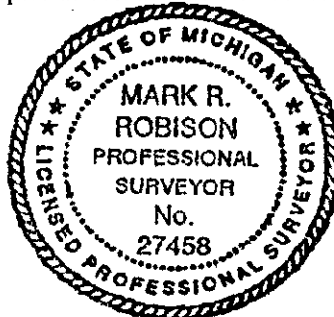

Signed by *Mark R. Robison*  
Surveyor's Michigan License No. 27458

Date 9-15-99