

SURVEY &
REMONUMENTATION

MAR 24 2000

LAND CORNER RECORDATION CERTIFICATE

Filing Requirement of Act 74, Mich. P.A. 1970

SECTION

Clare County Remonumentation

199900010460
Filed for Record in
CLARE COUNTY MICHIGAN
CAROL MCAULAY
On 12-03-1999 At 02:36 pm.
LAND CORNER 9.00
OR Liber 2 Page 98 - 98

For Corners in
Clare

(County)

Located In:

Corner Code#:

- 1. Public Land Survey T. 20N R. 3W D-9
T. _____ R. _____
T. _____ R. _____
- 2. Public Controlling S. _____ T. _____ R. _____
in Section S. _____ T. _____ R. _____
- 3. Miscellaneous S. _____ T. _____ R. _____
Property in Section S. _____ T. _____ R. _____
- 4. Lot No. _____, Recorded Plat _____
- 5. Private Claims _____

Instrument Liber Page
199900010460 OR 2 98

386-99

Register of Deeds Stamp & File Number

I, Mark R. Robison, in a field survey on October 15, 1999, do hereby certify that under requirements of P.A. 74, Michigan P.A. of 1970, the corner points mentioned in lines 1 and 2 above were in conformance with regulations and rules therefore as required in the current manual of survey instructions of the United States Department of the Interior, Bureau of Land Management or by a decree of a Court of Law and/or that the corner points mentioned in lines 3, 4 and 5 above were in conformance with the rules of the Michigan Board of Land Surveyors or by a Decree of a Court of Law, established, re-established, monumented, re-monumented, recovered, found as expressed below.

	A	B	C	D	E	F	G	H	I	J	K	L	M
1													
2	6	5	4	3	2	1							
3													
4	7	8	9	10	11	12							
5													
6	18	17	16	15	14	13							
7													
8	19	20	21	22	23	24							
9													
10	30	29	28	27	26	25							
11													
12	31	32	33	34	35	36							
13													

NOTE: Not more than 2 corners, all in the same town and range, may be recorded on this certificate.

A. Description of original monument and accessories and/or subsequent restoration:

- 1856 Adair
- 40.02 Set 1/4 Sec. Post No C.S.R.
- Beech 14 N70E 64 No Rec. Survey
- Beech 12 S58W 7 No L.C.R.S's

B. Description of corner evidence found and/or method applied in restoring or re-establishing corner:

Measured 5338.80 feet C-9 to E-9. Found line of occupation at East 1/8 corner with fence line to South. Fence line falls 1335 feet West of E-9 at S.P.M. division of North line of Section. Found no occupation at N1/4 corner on West 1/8 corner. Set D-9 on true line at S.P.M. between C-9 and E-9. Corner falls 6 feet South of C.L. Gravel Road. East post of fence brace post falls 38 feet East on S. side of road (No fence North or South. Used as B.T.).

C. Description of monument for corner and accessories established to perpetuate locating the position of the corner:

Set 5/8" x 36" rerod with Clare Co. Remon Cap marked P.S. #27458 in gravel road. Accepted as best available evidence of the accepted method of re-establishing the corner.

Witnesses:

- N53°E, 72.94 N & T in 20" Elm
- S55°E, 45.90 N & T in East post of brace post
- S64°E, 86.72 N & T in 20" Oak
- S46°W, 81.66 N & T in 30" Maple
- N33°W, 60.80 N & T in 12" Oak

APPROVED LAND CORNER


P.A. 345 of 1990

Clare County

Chairman *Paul S. Leph*

Date 12-01-99

Signed by _____
Surveyor's Michigan License No. _____

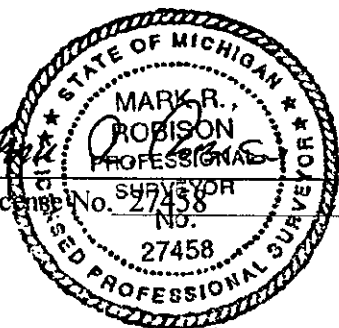

Date 12-1-99