

MAR 24 2000

LAND CORNER RECORDATION CERTIFICATE

Filing Requirement of Act 74, Mich. P.A. 1970

Clare County Remonumentation

199900010462 Filed for Record in CLARE COUNTY MICHIGAN CAROL MCAULLAY On 12-03-1999 At 02:36 pm. LAND CORNER 9.00 OR Liber 2 Page 100 - 100

SECTION

For Corners in Clare

Table with columns: (County), Located In: (Town, Range, Section), Corner Code#. Includes entries for Public Land Survey, Public Controlling, Miscellaneous, Lot No., and Private Claims.

Instrument 199900010462 OR Liber Page 2 100

388-99

Register of Deeds Stamp & File Number

I, Mark R. Robison, in a field survey on July 30, 1999, do hereby certify that under requirements of P.A. 74, Michigan P.A. of 1970, the corner points mentioned in lines 1 and 2 above were in conformance with regulations and rules therefore as required in the current manual of survey instructions of the United States Department of the Interior, Bureau of Land Management or by a decree of a Court of Law and/or that the corner points mentioned in lines 3, 4 and 5 above were in conformance with the rules of the Michigan Board of Land Surveyors or by a Decree of a Court of Law, established, re-established, monumented, re-monumented, recovered, found as expressed below.

Grid table with columns A-M and rows 1-13. Contains numerical data for survey points.

NOTE: Not more than 2 corners, all in the same town and range, may be recorded on this certificate.

A. Description of original monument and accessories and/or subsequent restoration:

- 1856 Adair 40.00 1/2 Set 1/4 Sec. Post B. Oak 18 N40W 10 Hemlock 18 S66E 27 1973 Lapham LCRC #130 Same witnesses as (132) 1-68 1973 Lapham, (132) 1-68 Set 1/2" capped rorod N28E 109.70 P. Pole East 94.08 NW Cor 2 St. Wd hse. S40W 100.30 8" Maple Cluster Center-line Rd. N00-16-00W 150.40 Notes indicate cor set by S.P.M. 1976 Sedgman Fd 1/2" bar capped Same witnesses & references LCRC #130


APPROVED LAND CORNER P.A. 345 of 1990 Clare County Chairman [Signature] Date 12-1-99

B. Description of corner evidence found and/or method applied in restoring or re-establishing corner:

See dossier for detailed report. Found 1/2" x 18 rorod 150' South of road. Found steel fence post 0.5' North of corner. Fence line to South starts 100' South of corner. Found two 1973 witnesses. House witnesses has been demolished but basement excavation fits witness call. Meas. West 2663.52 to G-9. Meas. 2664 via submeter GPS to I-9.

C. Description of monument for corner and accessories established to perpetuate locating the position of the corner:

Set 5/8" x 36" rorod with Clare Co. Remon Cap marked P.S. #27458. Accepted as best available evidence of the accepted position of the corner. Witnesses: N30°E 109.45 N & T in P.P. (OBT) S40°W 100.20 N & T in 10 x 12 x 8' Oak (OBT) S85°W 26.88 N & T in 10" Oak N35°W 50.48 N & T in 12" Maple

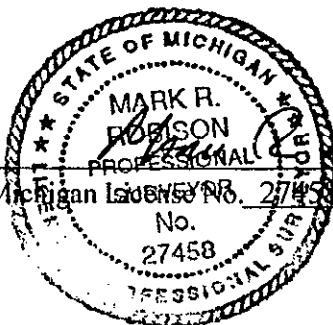

APPROVED LAND CORNER P.A. 345 of 1990 Clare County

Signed by [Signature] Chairman Date 12-1-99

Surveyor's Michigan License No. 27458 FORM APPROVED BY MICHIGAN STATE BOARD OF LAND SURVEYORS, JAN. 28, 1971