

LAND CORNER RECORDATION CERTIFICATE

Filing Requirement of Act 74, Mich. PA 1970

Clare County Remonumentation

For Corners In: Clare (County)	Located In	Corner Code #
1. Public Land Survey	T <u>20N</u> R <u>3W</u>	<u>E6</u>
	T _____ R _____	_____
2. Property Controlling in Section	S _____ T _____ R _____	_____
	S _____ T _____ R _____	_____
3. Miscellaneous Property in Section	S _____ T _____ R _____	_____
	S _____ T _____ R _____	_____
4. Lot No: _____	Recorded Plat: _____	
5. Private Claims: _____		

Register of Deeds Stamp & File Number

	A	B	C	D	E	F	G	H	I	J	K	L	M
1													
2	6		5		4		3		2		1		
3													
4	7		8		9		10		11		12		
5													
6	18		17		16		15		14		13		
7													
8	19		20		21		22		23		24		
9													
10	30		29		28		27		26		25		
11													
12	31		32		33		34		35		36		
13													

I, Craig W. McVean, in a field survey on Aug. 11 2003 do hereby state that under requirements of PA 74, Michigan PA of 1970, the corner points mentioned in lines 1 and 2 above were in conformance with regulations and rules therefore as required in the current manual of survey instructions of the United States Department of the Interior, Bureau of Land Management or by a decree of a Court of Law and/or that the corner points mentioned in lines 3, 4 and 5 above were in conformance with the rules of the Michigan Board of Land Surveyors or by a Decree of a Court of Law; established, re-established, monumented, recovered, found as expressed below:

NOTE: Not more than 2 corners, all in the same town and range, may be recorded on this certificate.

A. Description of original monument and accessories and/or subsequent restoration:

- | | |
|---|---|
| <p><u>E6</u> – GLO – Set ¼ post – G.E Adair -1856
 Y. Pine 12" N5°W 383 L.
 Y. Pine 12" S30°E 135 L.
 - G. D. Henning- 1963- Set 1 ¼" pipe & post midway between
 Sec. corners ½ miles N & S; 3" N. Pine S71°E 48.6'
 10" B. Oak S41°E 106.5'</p> | <p>- LCRC # 809-96 & L.1, Pg. 106 – M. R. Robinson - 1996
 found 1 ¼" pipe.
 S70°E 48.70' N&T 16" R. Pine
 S80°E 59.80' N&T 5" Oak
 S10°E 53.3' N&T 3" Pine
 S45°E 88.37' N&T 8" Maple clp.</p> |
|---|---|


B. Description of corner evidence found and/or method applied in restoring or re-establishing corner:

E6 – ¼ Cor. Common to Sec. 16 & 17, T20N, R3W - Found 1 ¼" I.D. iron pipe in Marsh per Henning & Robison. Measured south 463' +/- 3' vs. 504' GLO to N. edge of small lake. No GLO evidence found. 1 ¼" iron pipe accepted as the best available evidence of the position of the original corner.

C. Description of monument for corner and accessories established to perpetuate locating the position of the corner:

E6 – Drove 2" Alum. Cap- properly stamped- on 5/8" X 6' long iron rebar into center of found 1 ¼" iron pipe.
 Set Blue Carsonite Post 1' NW
 Reset steel fence post 1' E
 S83°E 59.79' to set Nail & Tag in S. side 8" W. Oak (MRR)
 S69°E 48.71' to set Nail & Tag in SW side 19" R. Pine (GH, MRR)
 S34°E 53.31' to set Nail & Tag in W side 7" J. Pine (MRR)
 N18°W 141.07' to set Nail & Tag in W side 10" W. Pine

-2" DNR Mon. in pipe used and accepted in place of Clare Co. Remon. Mon.

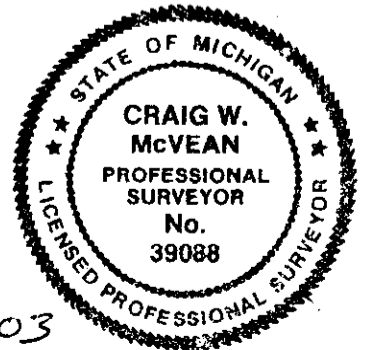

Signed by: Craig W. McVean
 Surveyor's Michigan License No.: 39088

Date: 8/27/2003