

LAND CORNER RECORDATION CERTIFICATE

Filing Requirement of Act 74, Mich. PA 1970

Clare County Remonumentation

For Corners In:
Clare Located In _____ Corner Code # _____
 (County)

1. Public Land Survey T 20N R 3W F3
 T _____ R _____ _____
 2. Property Controlling in Section S _____ T _____ R _____
 S _____ T _____ R _____
 3. Miscellaneous Property in Section S _____ T _____ R _____
 S _____ T _____ R _____


4. Lot No: _____ Recorded Plat: _____

5. Private Claims: _____

I, Craig W. McVean, in a field survey on Aug. 19 2003 do hereby state that under requirements of PA 74, Michigan PA of 1970, the corner points mentioned in lines 1 and 2 above were in conformance with regulations and rules therefore as required in the current manual of survey instructions of the United States Department of the Interior, Bureau of Land Management or by a decree of a Court of Law and/or that the corner points mentioned in lines 3, 4 and 5 above were in conformance with the rules of the Michigan Board of Land Surveyors or by a Decree of a Court of Law; established, re-established, monumented, recovered, found as expressed below:

NOTE: Not more than 2 corners, all in the same town and range, may be recorded on this certificate.

Register of Deeds Stamp & File Number

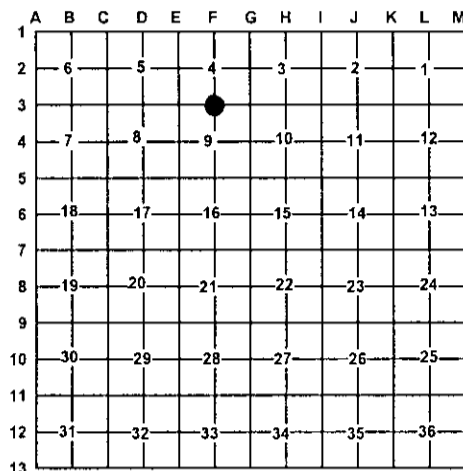

A. Description of original monument and accessories and/or subsequent restoration:

F3 – GLO – Set ¼ post – G.E Adair -1856
 Y. Pine 20" N59°W 254 L.
 W. Pine 13" S45°E 313 L.

B. Description of corner evidence found and/or method applied in restoring or re-establishing corner:

F3 – ¼ Cor. Common to Sec. 4 & 9, T20N, R3W - No GLO evidence found. Set 4" DNR Alum. Cap on 1" X 36" Galv. Iron pipe by single proportion to GLO between 'E3' & 'I-3'. Set DNR Mon. accepted as a careful & faithful re-established of the position of the original corner.

C. Description of monument for corner and accessories established to perpetuate locating the position of the corner:

F3 – 4" DNR Alum. cap on 1" X 36" Galv. Iron pipe.
 Set Blue Carsonite Post 1' NE
 N16°E 25.82' to set Nail & Tag in W. side 16" W. Pine scribed 'XBT'
 S62°E 74.33' to set Nail & Tag in SE side 10" W. Pine scribed 'XBT'
 N34°W 47.67' to set Nail & Tag in NW side 8" W. Pine scribed 'XBT'
 N63°W 70.99' to set Nail & Tag in S side 12" W. Pine Scribed 'XBT'
 -4" DNR Mon. used and accepted in place of Clare Co. Remon. Mon.



Signed by: Craig W. McVean Date: 8/27/2003
 Surveyor's Michigan License No.: 39088