LAND CORNER RECORDATION CERTIFICATE

Filing Requirement of Act 74, Mich. PA 1970

For Corners In:
Clare
(County)

	Located In			Corner Code #
1. Public Land Survey		T ____	R ____	____
		T ____	R ____	____
2. Property Controlling in Section	S 18	T 20N	R 3W	8
	S 18	T 20N	R 3W	15
3. Miscellaneous Property in Section	S ____	T ____	R ____	____
	S ____	T ____	R ____	____

Register of Deeds Stamp & File Number

4. Lot No: _____ Recorded Plat: _____

5. Private Claims: _____

I, Craig W. McVean, in a field survey on Sept. 16, 2003 do hereby state that under requirements of PA 74, Michigan PA of 1970, the corner points mentioned in lines 1 and 2 above were in conformance with regulations and rules therefore as required in the current manual of survey instructions of the United States Department of the Interior, Bureau of Land Management or by a decree of a Court of Law and/or that the corner points mentioned in lines 3, 4 and 5 above were in conformance with the rules of the Michigan Board of Land Surveyors or by a Decree of a Court of Law; established, re-established, monumented, recovered, found as expressed below:

NOTE: Not more than 2 corners, all in the same town and range, may be recorded on this certificate.

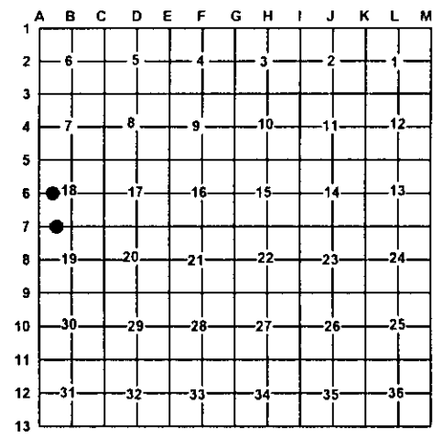

A. Description of original monument and accessories and/or subsequent restoration:

8 - None

15 – None

STATE OF MICHIGAN
CRAIG W. McVEAN
PROFESSIONAL SURVEYOR
No. 39088
LICENSED PROFESSIONAL SURVEYOR

B. Description of corner evidence found and/or method applied in restoring or re-establishing corner:

8 – CW 1/16 Cor., Sec. 18
Set 2" Alum. Cap on 5/8" x 34" Iron Rebar
per Standard BLM procedure.

15 – W 1/16 Cor. Common to Sec. 18 & 19
Set 2" Alum. Cap on 5/8" x 34" Iron Rebar
per Standard BLM procedure.

C. Description of monument for corner and accessories established to perpetuate locating the position of the corner:

8 – 2" Alum. Cap. stamped on 5/8" x 34" rebar
N74°W 21.79' to set N & T in S side 8" R. Pine
N13°W 11.06' to set N & T in E side 5" R. Pine
S77°E 12.76' to set N & T in N side 4" R. Pine
S28°E 15.35' to set N & T in E side 6" Oak
Set blue carsonite post 1' NE.

15 – 2" Alum. Cap. stamped on 5/8" x 34" rebar
Set blue carsonite post 1' NE
S33°W 12.22' to set N & T in SE side Tri 20" Maple
N70°W 27.58' to set N & T in SW side 12" R. Maple Clp.
N16°W 34.40' to set N & T in E side 16" R. Maple Clp. 6
S67°E 58.82' to set N & T in NW side 24" W. Pine

Signed by: Craig W. McVean Date: 12/3/2003

Surveyor's Michigan License No.: 39088

FORM APPROVED BY MICHIGAN STATE BOARD OF PROFESSIONAL SURVEYORS JAN. 28, 1971
Revised May 14, 1975
Revised Jan. 1983
Revised Oct. 1995