

LAND CORNER RECORDATION CERTIFICATE

Filing Requirement of Act 74, Mich. PA 1970


For Corners In: _____ Located In _____ Corner Code # _____
 (County) _____

1. Public Land Survey	T _____	R _____	_____
	T _____	R _____	_____
2. Property Controlling in Section	S 5 _____	T 20N _____	R 3W _____
	S 5 _____	T 20N _____	R 3W _____
	_____	_____	9 _____
3. Miscellaneous Property in Section	S _____	T _____	R _____
	S _____	T _____	R _____

4. Lot No: _____ Recorded Plat: _____
 5. Private Claims: _____

1. Craig W. McVean, in a field survey on Sept. 16, 2003 do hereby state that under requirements of PA 74, Michigan PA of 1970, the corner points mentioned in lines 1 and 2 above were in conformance with regulations and rules therefore as required in the current manual of survey instructions of the United States Department of the Interior, Bureau of Land Management or by a decree of a Court of Law and/or that the corner points mentioned in lines 3, 4 and 5 above were in conformance with the rules of the Michigan Board of Land Surveyors or by a Decree of a Court of Law, established, re-established, monumented, recovered, found as expressed below:

NOTE: Not more than 2 corners, all in the same town and range, may be recorded on this certificate.

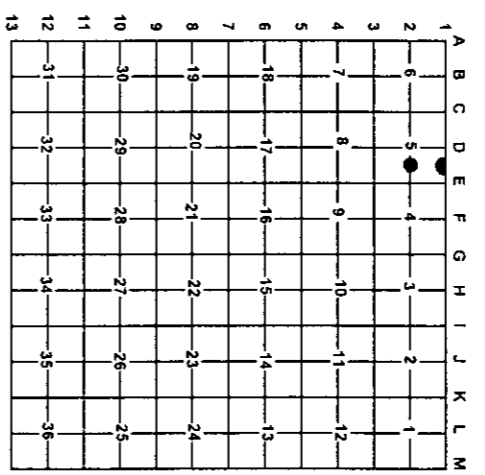

- A. Description of original monument and accessories and/or subsequent restoration:
- 2 - North Central Survey Co. - Larry L. Cavanagh - 1979
 - Set 4" x 36" Concrete Monument
 - Project # 78350 - Unrecorded Survey
 - 6" Poplar S30°W 4.15
 - 4" Cherry N50°W 7.64'
 - 9 - North Central Survey Co. - Larry L. Cavanagh - 1979
 - Set 4" x 36" Concrete Monument
 - Project # 78350 - Unrecorded Survey
 - 8" Poplar East 8.60'
 - 8" Poplar S40°E 14.39'

- B. Description of corner evidence found and/or method applied in restoring or re-establishing corner:
- 2 - E 1/16th corner on north line of Section 5 and common to Sec. 5 only. Set 2" Aluminum Cap on 5/8" x 34" rebar per standard BLM procedure.
 - Reference Pt. - S86°15'E 1.96' from corner "2" to fd. 4" Concrete Monument w/ cap # 17614. 4" Concrete Monument Not within acceptable accuracy and is not utilized as corner "2" in this Survey.
 - 9 - CE 1/16th corner Section 5. Set 2" Aluminum Cap on 5/8" x 34" rebar per standard BLM procedure. Falls in triangle of land between 2 tracks SW-NE, SE & E-W.
 - Reference Pt. - N84°16'W 22.77' from corner "9" to fd. 4" Concrete Monument with 1/2" iron per Cavanagh. 4" Concrete Monument based on rejected Gov't. corner positions and is not utilized as corner "9" in this Survey.

- C. Description of monument for corner and accessories established to perpetuate locating the position of the corner:
- 2 - 2" Aluminum Cap on 5/8" x 34" iron rebar.
 - Set Blue Carsonite post 1' NE
 - N79°W 18.67' to set N & T in S. side 10" White Pine
 - N07°W 30.39' to set N & T in W. side 18" Red Pine
 - N59°E 54.12' to set N & T in SE. side 20" Red Pine
 - S41°E 23.59 to set N & T in NE. side 2" Jack Pine
 - S86°15'E 1.96' to Reference Pt. - 4" Concrete Monument
 - 9. - 2" Aluminum Cap on 5/8" x 34" iron rebar.
 - Set Blue Carsonite post 1' SE
 - North 4.41' to set N & T in W. side 3" red maple
 - N71°E 23.07' to set N & T in S. side 10" Oak
 - S20°E 42.22' to set N & T in SE. side 14" White Pine
 - S24°W 48.37' to set N & T in NW. side 5" White Pine
 - N84°16'W 22.77' to Reference Pt. - 4" Concrete Monument

Signed by: Craig W. McVean
 Surveyor's Michigan License No.: 39088

Date: 12/3/2003

