

LAND CORNER RECORDATION CERTIFICATE
Filing Requirement of Act 74, Mich. PA 1970

For Corners In: _____ Located In _____ Corner Code # _____
CLARE _____
(County)

1. Public Land Survey T _____ R _____
2. Property Controlling in Section S 4 T 20N R 3W 13
S 4 T 20N R 3W 14
3. Miscellaneous Property in Section S _____ T _____ R _____
S _____ T _____ R _____

4. Lot No: _____ Recorded Plat: _____

5. Private Claims: _____

1. Craig W. McVean, in a field survey on Sept. 9, 2003 do hereby state that under requirements of PA 74, Michigan PA of 1970, the corner points mentioned in lines 1 and 2 above were in conformance with regulations and rules therefore as required in the current manual of survey instructions of the United States Department of the Interior, Bureau of Land Management or by a decree of a Court of Law and/or that the corner points mentioned in lines 3, 4 and 5 above were in conformance with the rules of the Michigan Board of Land Surveyors or by a Decree of a Court of Law, established, re-established, monumented, recovered, found as expressed below:


NOTE: Not more than 2 corners, all in the same town and range, may be recorded on this certificate.

	A	B	C	D	E	F	G	H	I	J	K	L	M
1													
2													
Register of Deeds Stamp & File Number

A. Description of original monument and accessories and/or subsequent restoration:

13 - None 14 - None

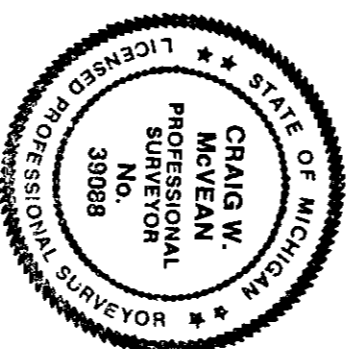

B. Description of corner evidence found and/or method applied in restoring or re-establishing corner:

- 13 - SE 1/16 Corner Section 4. 14 - S 1/16 corner common to Section 3 and Section 4.
- Set 2" Aluminum Cap on 5/8" x 3/4" rebar per standard BLM Procedure. Set 2" Aluminum Cap on 5/8" x 3/4" rebar per standard BLM procedure.
- East 27.5' to C.L. of Gravel Rd. - N - S

C. Description of monument for corner and accessories established to perpetuate locating the position of the corner:

- 13 - 2" Aluminum Cap on 5/8"x3/4" iron rebar. 14 - 2" Aluminum Cap on 5/8" x 3/4" iron rebar.
- Set Blue Carsonite Post 1' SW Set Blue Carsonite Post 1' SW
- N22°W 21.51' to set N & T in SW side twin 10" White Oak N78°W 120.99' to SE Corner of Hse. # 11259
- S55°E 64.18' to set N & T in NE side 8" Red Pine S37°W 69.25' to set N & T in SE side 7" Jack Pine
- S13°E 70.58' to set N & T in W side 6" White Pine S04°W 67.14' to set N & T in W side twin 8" Black Cherry
- S56°E 19.28' to set N & T in SE side 16" Oak S80°E 69.74' to set N & T in N side 8" Oak

Signed by: Craig W. McVean Date: 12/3/2003
Surveyor's Michigan License No.: 39088