

LAND CORNER RECORDATION CERTIFICATE

Filing Requirement of Act 74, Mich. PA 1970

For Corners In: _____ Located In _____ Corner Code # _____
 Clare _____
 (County)

1. Public Land Survey T 20N R 3W D12
T _____ R _____
2. Property Controlling in Section S _____ T _____ R _____
S _____ T _____ R _____
3. Miscellaneous Property in Section S _____ T _____ R _____
S _____ T _____ R _____

4. Lot No: _____ Recorded Plat: _____
 5. Private Claims: _____

1. Craig W. McVean, in a field survey on Oct. 9, 2003 do hereby state that under requirements of PA 74, Michigan PA of 1970, the corner points mentioned in lines 1 and 2 above were in conformance with regulations and rules therefore as required in the current manual of survey instructions of the United States Department of the Interior, Bureau of Land Management or by a decree of a Court of Law and/or that the corner points mentioned in lines 3, 4 and 5 above were in conformance with the rules of the Michigan Board of Land Surveyors or by a Decree of a Court of Law; established, re-established, monumented, recovered, found as expressed below:

NOTE: Not more than 2 corners, all in the same town and range, may be recorded on this certificate.


	A	B	C	D	E	F	G	H	I	J	K	L	M
1													
2	6	5	4	3	2	1							
3													
4	7	8	9	10	11	12							
5													
6	18	17	16	15	14	13							
7													
8	19	20	21	22	23	24							
9													
10	30	29	28	27	26	25							
11													
12	31	32	33	34	35	36							
13													

Register of Deeds Stamp & File Number

- A. Description of original monument and accessories and/or subsequent restoration:
 D12 - LCRC #793-97 and L. 1, p. 1045
 P. B. Lapham - 1995 - Set 1/2" capped re-rod. East 21.88' N & T in 8" cedar
 N5°W 12.78' N & T in 12" Cedar
 S89°W 7.55' N & T in 4" Ash
 S3°E 6.8' N & T in 7" Ash

- B. Description of corner evidence found and/or method applied in restoring or re-establishing corner:
 D12 - C 1/4 Sec. 32 - Fd. 1/2" x 18" capped iron rebar #9433 in old down N-S fence line per LCRC. Fd. 1/2" CIR is 0.30' N and 0.06' W of calculated intersection of 1/4 lines. N. Bank of 5' wide stream W and SE - Flow SE - is 27' S. Accepted 1/2" CIR as the best available evidence of the position of the corner.

- C. Description of monument for corner and accessories established to perpetuate locating the position of the corner:
 D12 - Replaced 1/2" x 18" CIR #9433 w/ stamped 2" Alum. Cap on 5/8" x 3/4" iron rebar in ring of stones.
 N80°W 7.44' to set N & T in N. side 6" Ash (PBL)
 N14°W 12.71' to set N & T in E. side 12" Cedar (PBL)
 N86°E 22.01' to set N & T in S. side 10" Cedar (PBL)
 S33°E 24.06' to set N & T in NE side 13" R. Maple
 Set orange carsonite post 1' N
 Reset steel fence post 1' W

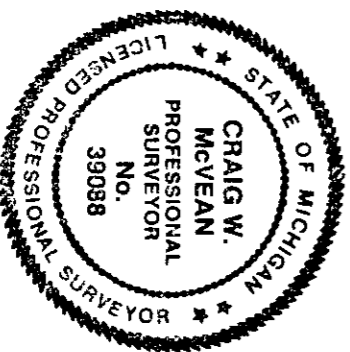

Signed by: Craig W. McVean

Date: 12/3/2003