

LAND CORNER RECORDATION CERTIFICATE

Filing Requirement of Act 74, Mich. PA 1970

For Corners In: _____ Located In _____ Corner Code # _____
 (County)

1. Public Land Survey T 20N R 3W D6
T _____ R _____
2. Property Controlling in Section S 17 T 20N R 3W 7
S _____ T _____ R _____
3. Miscellaneous Property in Section S _____ T _____ R _____
S _____ T _____ R _____

4. Lot No: _____ Recorded Plat: _____
 5. Private Claims: _____

1. Craig W. McVean, in a field survey on Sept. 9, 2003 do hereby state that under requirements of PA 74, Michigan PA of 1970, the corner points mentioned in lines 1 and 2 above were in conformance with regulations and rules therefore as required in the current manual of survey instructions of the United States Department of the Interior, Bureau of Land Management or by a decree of a Court of Law and/or that the corner points mentioned in lines 3, 4 and 5 above were in conformance with the rules of the Michigan Board of Land Surveyors or by a Decree of a Court of Law; established, re-established, monumented, recovered, found as expressed below:


NOTE: Not more than 2 corners, all in the same town and range, may be recorded on this certificate.

	A	B	C	D	E	F	G	H	I	J	K	L	M
1													
2	6	5	4	3	2	1							
3													
4	7	8	9	10	11	12							
5													
6	18	17	16	15	14	13							
7													
8	19	20	21	22	23	24							
9													
10	30	29	28	27	26	25							
11													
12	31	32	33	34	35	36							
13													

Register of Deeds Stamp & File Number

A. Description of original monument and accessories and/or subsequent restoration:

D6 - NONE
 Z - G. D. Henning - 1963
 Set 1/2" bar & post
 8" W. Oak S64°E 26.3'
 5" Maple S45°W 15.0'

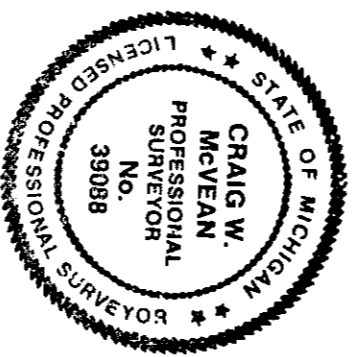

B. Description of corner evidence found and/or method applied in restoring or re-establishing corner:

D6 - C 1/4 corner section 17 - set 2" aluminum cap on 5/8" X 3/4" rebar at intersection of quarter lines per standard BLM procedure.
 Found 1/2" CIR #27458 - S88°15'E 3.46' of set 2" AC.
 M. Robison had established this position based on DNR working drawing position 'D5' that was not accepted by Remon. Peer review group.
 Z - N 1/16 corner common to sec 16 & 17 - found 1/2" X 24" iron rebar per Henning, 0.08'N & 0.51' E of Calc. position. Also found 1/2" CIR # 9433 - 0.14' W & 0.46' S of calc. position. Accepted Hennings' 1/2" iron as the best available evidence of the corner since it was placed first and Lapham's position is based on Henning position at 'E5' & 'E6'

C. Description of monument for corner and accessories established to perpetuate locating the position of the corner:

D6 - 2" Alum. Cap stamped on 5/8" x 3/4" iron rebar
 Set Blue Carsonite Post 1' NE
 N71°E 31.26' to set N&T in N side 12" Oak
 N13°W 29.29' to set N&T in E side tw. 10" R. Maple
 N65°W 29.64' to set N&T in SW side 12" W. Oak clip -4
 S11°W 11.35' to set N&T in E side 9" R. Maple
 S88°15'E 3.46' to found 1/2" CIR #27458
 Z - Replaced Henning 1/2" X 24" iron with stamped 2" aluminum cap on 5/8" X 3/4" iron rebar.
 N27°W 26.27' to set N&T in E side 12" Oak.
 S6°E 17.95' to set N&T in E side 9" Oak
 S65°W 45.18' to set N&T in SE side 5" Oak
 N72°E 15.42' to set N&T in S side 2" R. Maple CLP.
 S63°E 26.1' to blaze on Oak STP (GDH)
 S34°03W 0.65' to 1/2" CIR # 9433
 Set Blue Carsonite Post 1' SW
 Reset steel fence post 1' N.

Signed by: Craig W. McVean Date: 12/3/2003
 Surveyor's Michigan License No.: 39088