

CLARE County Remonumentation
LAND CORNER RECORDATION CERTIFICATE
 Filing Requirement of Act 74, Mich. P.A. 1970

RECEIVED
 #280-98
 98 NOV 18 AM 9:55
 REGISTER OF DEEDS
 CLARE COUNTY
 CAROL A. McAULAY

For corners in

<u>CLARE</u> (County)	Located in:	Corner Code #
1. Public Land Survey	T20N R04W	D-7
	T R	
	T R	
	T R	
2. Property Controlling in Section	S T R	
	S T R	
3. Miscellaneous Property in Sec.	S T R	
	S T R	

Register of Deeds Stamp & File Number

4. Lot No. _____, Recorded Plat _____
 5. Private Claims _____

I, Mark R Robison, in a field survey on June 8, 1998 do hereby state that under requirements of P.A. 74, Michigan P.A. of 1970, the corner points mention in lines 1 and 2 above were in conformance with regulations and rules therefore as required in the current manual of survey instructions of the United States Department of the Interior, Bureau of Land Management or by a decree of a Court of Law and/or that the corner points mentioned in lines 3, 4 and 5 above were in conformance with the rules of the Michigan Board of Land Surveyors or by a Decree of a Court of Law; established, re-established, monumented, recovered, found as expressed below:

	A	B	C	D	E	F	G	H	I	J	K	L	M
1													
2	6		5		4		3		2		1		
3													
4	7		8		9		10		11		12		
5													
6	18		17		16		15		14		13		
7													
8	19		20		21		22		23		24		
9													
10	30		29		28		27		26		25		
11													
12	31		32		33		34		35		36		
13													

NOTE: Not more than 2 corners, all in the same town and range, may be recorded on this certificate

A. Description of original monument and accessories and/or subsequent restoration:

D-7: 1856 Adair GLO
 Set 1/4 Sec Post
 Wit-Maple 12 N45W 28 1/2
 Hemlock 16 S43E 25

11-14-91 Roser LCRC#644
 Drove 5/8" rerod midway & on-line between Fd Sec Cors E-W. Old W.W.
 Fn. is 48' N & is on N-edge of old E-W Pine Stump Fence. Field berm (looking N) is 23' E.
 Wit-Drove 5/8" x 34" rerod
 3" W. Birch N15E 46.14
 18" B. Cherry N75E 144.85
 22" Apple S10W 28.32
 Set Ced Post North 43'

**SURVEY &
 REMONUMENTATION**

NOV 25 1998

SECTION

B. Description of corner evidence found and/or method applied in restoring or reestablishing corner:


D-7: Found 5/8" x 34" Iron with DNR cap and all 1991 witnesses. Corner falls at NE corner of old apple orchard.

See dossier for detailed report.

C. Description of monument for corner and accessories established to perpetuate locating the position of the corner:

D-7: Set 5/8" x 36" rerod with Clare Co. Remon. Cap marked P.S.#27458. Accepted as best available evidence of the accepted method of re-establishing the corner.

Witnesses:
 North 43.40', nail & tag, DNR Cedar Post (OBT)
 N08E 46.14', nail & tag, 5" Birch (OBT)
 N75E 144.85', nail & tag, 20" B. Cherry
 S10W 28.32', nail & tag, 22" Apple

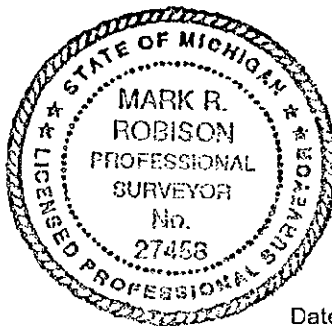

APPROVED LAND CORNER

P.A. 345 of 1990

Clare County

Chairman Paul J. Leph

Date 9-22-98

Signed by Mark R. Robison

Date 11-16-98

Surveyor's Michigan License No. 27458