

SURVEY & REMONUMENTATION

JAN 14 1999

CLARE County Remonumentation

SECTION

LAND CORNER RECORDATION CERTIFICATE Filing Requirement of Act 74, Mich. P.A. 1970

For corners in

CLARE	Located in:	Corner Code #	
(County)			
1. Public Land Survey	T20N R04W	E-7	
	T R		
	T R		
	T R		
2. Property Controlling in Section	S T R		
	S T R		
3. Miscellaneous Property in Sec.	S T R		
	S T R		

RECORDED
307-98
98 NOV 24 AM 10:23
REGISTER OF DEEDS
CLARE COUNTY
CAROL A. McCAULAY

Register of Deeds Stamp & File Number

4. Lot No. _____, Recorded Plat _____
5. Private Claims _____

I, Mark R Robison, in a field survey on June, 1998 do hereby state that under requirements of P.A. 74, Michigan P.A. of 1970, the corner points mention in lines 1 and 2 above were in conformance with regulations and rules therefore as required in the current manual of survey instructions of the United States Department of the Interior, Bureau of Land Management or by a decree of a Court of Law and/or that the corner points mentioned in lines 3, 4 and 5 above were in conformance with the rules of the Michigan Board of Land Surveyors or by a Decree of a Court of Law; established, re-established, monumented, recovered, found as expressed below:

	A	B	C	D	E	F	G	H	I	J	K	L	M
1													
2	6		5		4		3		2		1		
3													
4	7		8		9		10		11		12		
5													
6	18		17		16		15		14		13		
7													
8	19		20		21		22		23		24		
9													
10	30		29		28		27		26		25		
11													
12	31		32		33		34		35		36		
13													

NOTE: Not more than 2 corners, all in the same town and range, may be recorded on this certificate

A. Description of original monument and accessories and/or subsequent restoration:


<p>E-7: 1856 Adair GLO Set post cor sec's 16-17-20-21 Wit-Beech 13 N12W 4 Hemlock 16 S62E 52</p> <p>7-14-73 Urbaniak (132) 1-511 Set axel shaft & rocks. Notes indicate cor set SPM btwn C-7&G-7 Wit-N51W 52.03 Fence Post N42E 74.58 14" Apple Tree S67E 95.35 10" Red Oak</p>	<p>11-14-91 Roser Fd 7/8" sq Iron. Cor is in line w/ctr of grv Rd E & 22'E of ctr Gr. Rd S. Old E-W Fn remains are 28' N. Fd 1/2" Iron. Wit-S45E 47.03 per Cert Surv 1-511 N35W 47.02 spike Sly root 18" Tw.Maple N40E 74.23 spike Sly root 16" Apple S46E 44.36 P.P. West 33' Set Ced Post</p>
--	---

B. Description of corner evidence found and/or method applied in restoring or reestablishing corner:
E-7: Found 7/8" square iron and all 1973 and 1991 witnesses. Measured South 2644.58 (Recorded 2645.50) to E-8. Recorded East 2638.80 to F-7.

See dossier for detailed report.

C. Description of monument for corner and accessories established to perpetuate locating the position of the corner:
E-7: Set 5/8" x 36" rod with Clare Co. Remon. Cap marked P.S.#27458. Accepted as best available evidence of the accepted position of the corner.

Witnesses:
N45E 74.23', nail & tag, 17" Apple (OBT)
N35W 47.02', nail & tag, 24" x 18" Twin Maple (OBT)
S46E 44.36', nail & tag, P.P. (OBT)
N45W 43.78', nail & tag, Fence Post
West 33.00', nail & tag, DNR Cedar Post (OBT)

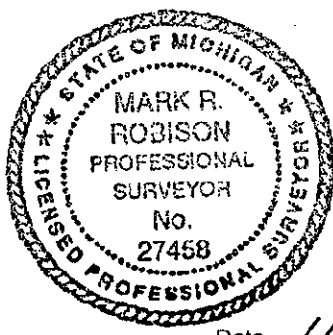

APPROVED LAND CORNER
P.A. 345 of 1990
Clare County
Chairman Paul B. Tophan
Date 9-22-98

Signed by Mark R. Robison
Surveyor's Michigan License No. 27458

Date 11-23-98