

RECEIVED
5 7 10 A D
1993 DEC 20 PM 1:43
REGISTER OF DEEDS
CLARE COUNTY
DONNA M CARR

For corners in

CLARE
(County)

Located In:

Corner Code ##

1. Public Land Survey	T	20N	R	4W	G-9
	T		R		
	T		R		
	T		R		
2. Property Controlling in Section	S		T	R	
	S		T	R	
3. Miscellaneous Property in Sec.	S		T	R	
	S		T	R	

Register of Deeds Stamp & File Number

4. Lot No. _____, Recorded Plat _____
5. Private Claims _____

I, MARK R. ROBISON, in a field survey on NOVEMBER, 19 93, do hereby certify that under requirements of P.A. 74, Michigan P.A. of 1970, the corner points mentioned in lines 1 and 2 above were in conformance with regulations and rules therefore as required in the current manual of survey instructions of the United States Department of the Interior, Bureau of Land Management or by a decree of a Court of Law and/or that the corner points mentioned in lines 3, 4 and 5 above were in conformance with the rules of the Michigan Board of Land Surveyors or by a Decree of a Court of Law; established, re-established, monumented, re-monumented, recovered, found as expressed below:

NOTE: Not more than 4 corners, all in the same town and range, may be recorded on this certificate.


A. Description of original monument and accessories and/or subsequent restoration:
1856 G.E. ADAIR, Y. PINE 22" N 30°W, 23 LKS P.427
Y. PINE 12" S 47°E, 24 LKS
5-5-55 W.S. MOORE, CAST IRON MON. BOX CSR 3-28
5-5-72 LAPHAM, LCRC 33-72
10-2-72 LAPHAM, LCRC 63-72
10-15-79 SEDGEMAN, LCRC 344-79
9-27-84 LAPHAM, LCRC 479-85

B. Description of corner evidence found and/or method applied in restoring or reestablishing corner:
FOUND 1-1/2" x 15" SOLID BAR IN MONUMENT BOX OVER 5/8" x 15" POINTED BAR. BOTH BARS, VERY OLD & RUSTED. EXCAVATED TO DEPTH OF 3', DID NOT FIND FURTHER EVIDENCE.
FOUND RECORDED WITNESSES:
N 62°W, 69.92' - TELE. POLE
N 80°E, 143.04' - S.W. COR. STORE
S 45°E, 119.48' - N.W. COR. STORE

A	B	C	D	E	F	G	H	I	J	K	L	M
2	6	5	4	3	2	1						
3												
4	7	8	9	10	11	12						
5												
6	18	17	16	15	14	13						
7												
8	19	20	21	22	23	24						
9												
10	30	29	28	27	26	25						
11												
12	31	32	33	34	35	36						
13												

This Corner established in Clare County Remonumentation Program.
See dossier for detailed report.

C. Description of monument for corner and accessories established to perpetuate locating the position of the corner:
SET 5/8" X 36" RE-ROD WITH 3" CLARE COUNTY MONUMENT CAP.
N 60°W, 70.83' - POWER POLE
N 80°E, 143.04' - S.W. COR. STORE BLDG.
S 45°E, 119.48' - N.W. COR. STORE BLDG.
S 45°W, 108.00' - N.E. COR. M.B.T. SUBSTATION BLDG.

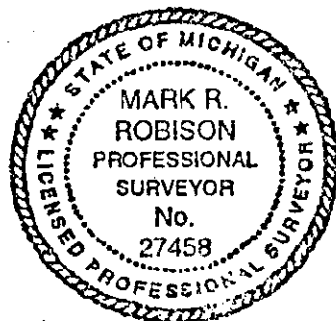

Signed by Mark R. Robison

Date 11/24/93

Surveyor's Michigan License No. 27458