

FEB 1 8 1994

CLARE COUNTY REMONUMENTATION PROGRAM

	COMMISSION	•	ER RECORDATION CERTI		1993 0	ER 20 P	14	D
Fo	or corners in	Filing Requir	rement of Act 74, Mich. P.	.A. 1970	REGIST	. ~0 /	<i>y</i> ,	-546
	CLARE	Located In:	Corner Code ##		DOLAR	ER OF .	1:4	က
_	(County)	Located in:	Corner Code -++		VVA	SOUNT	Ene	•
1.	Public Land Survey	T R 4W	J-9			" CAR	ψ. Σ-23	
	in Section Miscellaneous	T R T R S T R S T R S T R		Register o	of Deeds Sta	amp & File	: Numb	er
	Lot No, Rec Private Claims			2 3	B C D E	F G H	J 1	K L
1, _		n a field survey on	, 19	,	7 8	-9-10-		12-
in Cu Ma ab Co	lines 1 and 2 above were in co arrent manual of survey instruction anagement or by a decree of a Co above were in conformance with the	onformance with regulations a ions of the United States Depa ourt of Law and/or that the corn he rules of the Michigan Board	a. of 1970, the corner points mention of rules therefore as required in rtment of the Interior, Bureau of er points mentioned in lines 3, 4 a of Land Surveyors or by a Decree monumented, recovered, foun	n the Land 7 and 5 8 of a street	19 20	-16 -15 - -2122 - -28 27 -	23-26-	24
N	OTE: Not more than 4 corr on this certificate.	iers, all in the same town a	and range, may be recorded	11 12 13	3132	-33 - 34-	35	36
A.	Description of original mo 1856 G.E. ADAIR, BEEC Y. F 9-5-79 LAPHAM, LCRO	PINE 20" S 18°E, 31 LKS	nd/or subsequent restoration SLO. 421	:				

B. Description of corner evidence found and/or method applied in restoring or reestablishing corner: FOUND 1/2" x 18" ROD SHARPENED ON POINT. EXCAVATED TO A DEPTH OF 3', DID NOT FIND ADDITIONAL EVIDENCE.


FOUND RECORDED WITNESSES:

NORTH 24.97' - NAIL IN 4" MAPLE (MAPLE CLUMP)

N 20°W, 26.04' - CENTER, 6" OAK

S 40°E, 67.70' - NAIL IN TELE. POLE

This Corner established in Clare County Remonumentation Program. See dossier for detailed report.

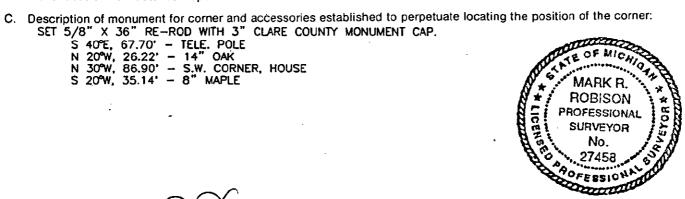

Signed by	MANU (2)	Chi
orgrice by		27458

Date