SURVEY & REMONUMENTATION

FEB 18 1994

COMMISSION

RECEIVED 1993 DEC 20 PM 1:44 REGISTER OF DEEDS CLARE COUNTY DONNA M. CARR

CLARE COUNTY REMONUMENTATION PROGRAM

LAND CORNER RECORDATION CERTIFICATE

Filing Requirement of Act 74, Mich. P.A. 1970

For corners in: CLARE (County)

	Located In:	Corner Code #
1. Public Land Survey	T 20N R 4W	K-12
	T ___ R ___	
	T ___ R ___	
	T ___ R ___	
2. Property Controlling	S ___ T ___ R ___	
in Section	S ___ T ___ R ___	
3. Miscellaneous	S ___ T ___ R ___	
Property in Sec.	S ___ T ___ R ___	

Register of Deeds Stamp & File Number

4. Lot No. _____ , Recorded Plat _____
5. Private Claims _____

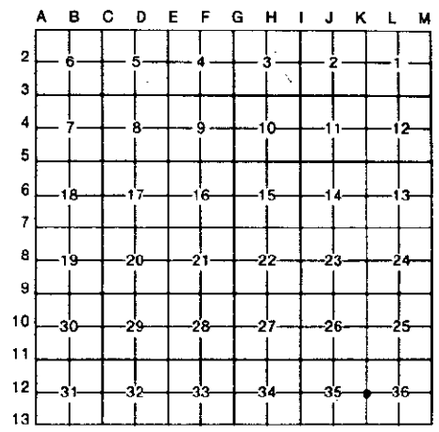

I, MARK R. ROBISON, in a field survey on NOVEMBER, 19 93, do hereby certify that under requirements of P.A. 74, Michigan P.A. of 1970, the corner points mentioned in lines 1 and 2 above were in conformance with regulations and rules therefore as required in the current manual of survey instructions of the United States Department of the Interior, Bureau of Land Management or by a decree of a Court of Law and/or that the corner points mentioned in lines 3, 4 and 5 above were in conformance with the rules of the Michigan Board of Land Surveyors or by a Decree of a Court of Law; established, re-established, monumented, re-monumented, recovered, found as expressed below:

NOTE: Not more than 4 corners, all in the same town and range, may be recorded on this certificate.

A. Description of original monument and accessories and/or subsequent restoration:
1856 G.E. ADAIR, W. PINE 36" N 25°W, 31 LKS P.413
W. PINE 30" S 42°E, 37 LKS
JULY/SEPT '55, W.S. MOORE, 12" POPLAR S 74°45'W, 37.5' CSR 3-43
6" POPLAR S 69°05'E, 45.1'
JAN 6/14/56 F. McCLUNG CSR 3-88
6-26-73 SEDGEMAN, SET 1/2" RE-ROD, (132) 1-519
7-24-73 LAPHAM, LCRC 112-73
5-3-93 MUELLER, (132) 3-391

B. Description of corner evidence found and/or method applied in restoring or reestablishing corner:
FOUND 1/2" x 18" IRON. MEASURED NORTH 2686.91' TO SECTION CORNER. G.L.O. REC. 2688.51' (132) 1-519 REC. 2686.91'. (132) 3-391 REC. 2677.66 WHICH FITS A CABIN SPIKE APPROXIMATELY 10 FEET SOUTH OF SECTION CORNER. CORNER SET IN (132) 1-519 WAS SET SINGLE PROPORTIONATE MEASURE BETWEEN SECTION CORNERS
FOUND RECORDED WITNESSES:
S 50°W, 27.57' - 5" MAPLE
N 40°W, 55.29' - 8" MAPLE
S 20°E, 85.79' - COR. FENCE POST
N 34°E, 24.30' - 5" W. PINE

This Corner established in Clare County Remonumentation Program.
See dossier for detailed report.

C. Description of monument for corner and accessories established to perpetuate locating the position of the corner:
SET 5/8" X 36" RE-ROD WITH 3" CLARE COUNTY MONUMENT CAP.
N 40°W, 55.29' - 10" MAPLE
S 50°W, 27.51' - 9" MAPLE
N 34°E, 24.30' - 8" WHITE PINE
S 20°E, 85.79' - CORNER FENCE POST

STATE OF MICHIGAN
MARK R. ROBISON
PROFESSIONAL SURVEYOR
No. 27458
LICENSED PROFESSIONAL SURVEYOR

Signed by Mark R. Robison Date 11/24/93

Surveyor's Michigan License No. 27458

FORM APPROVED BY MICHIGAN STATE BOARD OF LAND SURVEYORS, JAN. 28, 1971
REVISED MAY 14, 1975
REVISED JAN., 1983