

LAND CORNER RECORDATION CERTIFICATE

FILING REQUIREMENT OF ACT 74, MICH. P.A.1970

FOR CORNERS OF--:	LOCATED IN--:	CORNER CODE NUMBER
1. PUBLIC LAND SURVEY _____	T. <u>20</u> ^{N.} <u>●</u> R. <u>4</u> ^{W.} <u>●</u>	<u>C-3; C-4; C-5</u>
2. PROPERTY CONTROLLING IN SECTION _____	T. <u>20</u> ^{N.} <u>●</u> R. <u>4</u> ^{W.} <u>●</u>	<u>12</u>
3. MISCELLANEOUS PROPERTY IN SECTION _____	T. _____ ^{N.} <u>●</u> R. _____ ^{E.} <u>●</u>	_____
4. LOT NO. _____, RECORDED PLAT _____		
5. PRIVATE CLAIMS _____		

REGISTER OF DEEDS STAMP AND FILING NUMBER

I, Kenneth J. Ostling, do hereby certify that under requirements of P.A. 74, Michigan P.A. of 1970, the corner points mentioned in lines 1 and 2 above were, in a field survey on October 15, 1975, established, re-established, monumented, re-monumented, recovered or restored as expressed below and in conformance with regulations and rules therefore as required in the current manual of survey instructions of the United States Department of the Interior, Bureau of Land Management or by a decree of a court of law. Furthermore, that the corner points mentioned in lines 3, 4 and 5 above were, in a field survey on _____, 19____, found, recovered, restored, established or re-established as expressed below and in conformance with the rules of the Michigan State Board of Registration for Land Surveyors or, by a Decree of a Court of law:

A. Description of original monument and accessories and/or subsequent restoration:


B. Description of corner evidence found and/or method applied in restoring or re-establishing corner:

- C-3 Found railroad spike at road intersection, set by unknown.
- C-4 Found 1½" pipe in $\frac{1}{2}$ N-S road; remains of old fence line west.
- C-5 Found 1½" pipe at center of road intersection, set by unknown. Best available evidence.
- 12 Set by standard survey procedure for the subdivision of sections.

C. Description of monument for corner and accessories established to perpetuate locating the position of the corner:

C-3	C-4	C-5
Set DNR monument	Left 1½" pipe in place	Left 1½" pipe in place
8" J.Pine N50°E 43.0	4" W.Pine N86°W 67.9	14" W.Birch S31°E 95.1
9" W.Pine S25°W 81.5	4" W.Pine S53°W 35.6	10" R.Oak N42°E 89.3
	12	
	Set 3' of 1½" pipe & red-top post	
	8" W. Oak S50°W 43.8	
	10" W. Oak N20°E 23.2	

SIGNED BY *Kenneth J. Ostling* DATE 1-9-76
 SURVEYOR'S MICHIGAN REGISTRATION NO. 10068

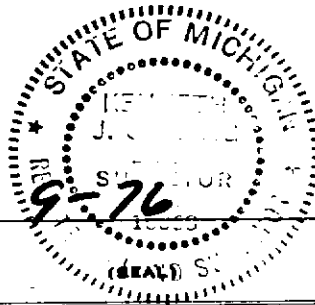

FOR STATE AND UNITED STATES AGENCIES:
 SIGNED BY _____ DATE _____
CHIEF OF SURVEY PARTY
 APPROVED AND SIGNED BY _____ DATE _____
MICHIGAN REGISTERED LAND SURVEYOR (SEAL)

SURVEYOR'S MICHIGAN REGISTRATION NO. _____