LAND CORNER RECORDATION CERTIFICATE

Filing Requirement of Act 74, Mich. P.A. 1970

For corners in CLARE (County)

	Located In:	Corner Code ##
1. Public Land Survey	T 20N R 4W	A-6. A-7.
	T ___ R ___	B-6
	T ___ R ___	
	T ___ R ___	
2. Property Controlling	S 18 T ___ R ___	8
in Section	S ___ T ___ R ___	
3. Miscellaneous	S ___ T ___ R ___	
Property in Sec.	S ___ T ___ R ___	

Register of Deeds Stamp & File Number

4. Lot No. _____ , Recorded Plat _____
5. Private Claims _____

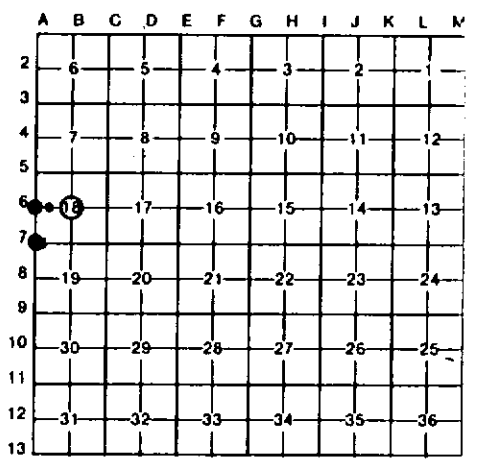

I, CARL F. ROSER, in a field survey on 01-10, 19 90, do hereby certify that under requirements of P.A. 74, Michigan P.A. of 1970, the corner points mentioned in lines 1 and 2 above were in conformance with regulations and rules therefore as required in the current manual of survey instructions of the United States Department of the Interior, Bureau of Land Management or by a decree of a Court of Law and/or that the corner points mentioned in lines 3, 4 and 5 above were in conformance with the rules of the Michigan Board of Land Surveyors or by a Decree of a Court of Law; established, re-established, monumented, re-monumented, recovered, found as expressed below:

NOTE: Not more than 4 corners, all in the same town and range, may be recorded on this certificate.

A. Description of original monument and accessories and/or subsequent restoration:

A-6	A-7	B-6	8

B. Description of corner evidence found and/or method applied in restoring or reestablishing corner:

A-6	A-7	B-6	8
ESTABLISHED W1/4 COR AT INTER OF W. LINE S-18 (BTW FD NW & SW CORS S-18) AND A LINE PROJ W. ACROSS FD E1/4 & CTR S-18.	FD 1-1/4" PIPE (10" OUT OF GROUND) FOR SW COR SEC 18. COR FITS 3 M. SCHAAF WITS.	FD 1/2" REROD BY C.E.OSTLING, RLS #12026. FOR CENTER OF SEC 18.	SET THE SW COR OF E1/2-NW1/4 OF SEC 18 PER STANDARD BLM INSTRUCTIONS. (PRO-RATED TO G.L.O.1856 RESURVEY, RUN-OUT SECTION.)

C. Description of monument for corner and accessories established to perpetuate locating the position of the corner:

A-6			A-7			B-6			8		
SET DNR MON & CED POST.			FD 1-1/4" GALV PIPE: ADDED RLS CAP.			FD 1/2" RE-ROD W/RLS CAP; SET CED POST W/LOC TAG.			DROVE 5/8"x 34" RE-ROD W/RLS CAP & SET CED POST W/LOC TAG.		
5" B.OAK	N20°E	25.5'	10" MAPLE	N25°W	8.85'	11" W.OAK	N15°E	16.6'	5" W.OAK	N40°W	1.9'
9" B.OAK	S85°E	31.8'	8" W.OAK	S85°E	14.84'	5" R.PINE	N65°E	82.7'	4" R.PINE	S30°E	43.9'
13" B.OAK	S20°W	32.1'	8" W.OAK	S10°E	51.33'	4" W.PINE	S75°E	29.6'	5" R.PINE	S85°W	35.6'
3" B.OAK	S70°W	6.6'	CTR E-W DIRT RD	DUE S	13'±1'	7" W.OAK	N55°W	60.6'			

Signed by Carl F. Roser 11-14-91 Date _____

Surveyor's Michigan License No. 12028

STATE OF MICHIGAN CARL F. ROSER LAND SURVEYOR No. 12028 REGISTERED LAND SURVEYOR

FORM APPROVED BY MICHIGAN STATE BOARD OF LAND SURVEYORS, JAN. 28, 1971
REVISED MAY 14, 1975
REVISED JAN., 1983