LAND CORNER RECORDATION CERTIFICATE

Filing Requirement of Act 74, Mich. P.A. 1970

For corners in CLARE (County)

	Located In:	Corner Code #t
1. Public Land Survey	T 20N R 4W	C-5, C-6,
	T ____ R ____	D-5, D-6
	T ____ R ____	
	T ____ R ____	
2. Property Controlling	S ____ T ____ R ____	
in Section	S ____ T ____ R ____	
3. Miscellaneous	S ____ T ____ R ____	
Property in Sec.	S ____ T ____ R ____	

Register of Deeds Stamp & File Number

4. Lot No. _____ , Recorded Plat _____
5. Private Claims _____

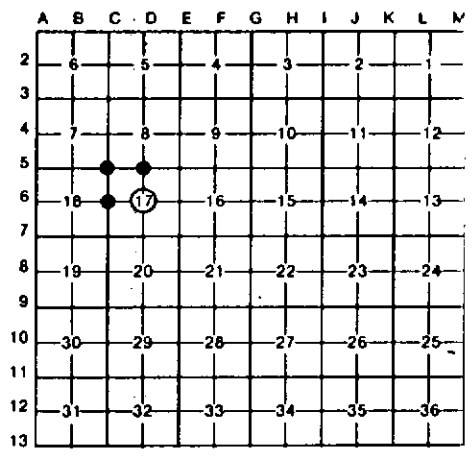

I, CARL F. ROSER , in a field survey on 01-10 , 19 90 , do hereby certify that under requirements of P.A. 74, Michigan P.A. of 1970, the corner points mentioned in lines 1 and 2 above were in conformance with regulations and rules therefore as required in the current manual of survey instructions of the United States Department of the Interior, Bureau of Land Management or by a decree of a Court of Law and/or that the corner points mentioned in lines 3, 4 and 5 above were in conformance with the rules of the Michigan Board of Land Surveyors or by a Decree of a Court of Law; established, re-established, monumented, re-monumented, recovered, found as expressed below:

NOTE: Not more than 4 corners, all in the same town and range, may be recorded on this certificate.

A. Description of original monument and accessories and/or subsequent restoration:

C-5	C-6	D-5	D-6

B. Description of corner evidence found and/or method applied in restoring or reestablishing corner:

C-5	C-6	D-5	D-6
FD 1" PIPE THAT FIT RLS, K. OSTLING, WIT FOR NW COR S-17. K. OSTLING FD 1-1/4" PIPE HERE IN 1976 DEPT SURVEY. COR IS IN APPROX INTER OF GRV RDS N-S-E.	FD 1/2" REROD FOR W1/4 COR S-17; IN APPROX CTR N-S GRAVEL RD; & IN LINE W/FNS E & W.	FD IRON, IN CTR E-W DIRT & GRAVEL RD, FOR N1/4 COR S-17. OLD FN N. IS 31'± W. & OLD FN S. IS 26'± W. FN E IS 19'± N.	ESTABLISHED CTR OF SEC 17 AT INTERSECITON OF 1/4 LINES. SET CORNER THRU ICE IN APPROX 3' OF WATER, IN BEAVER POND. CORNER IS IN APPROX LINE W/OLD E-W FN. EAST EDGE OF BEAVER POND IS 175'(±5') E. WEST EDGE OF BEAVER POND IS 344'(±15') W. NORTH EDGE OF BEAVER POND IS 475'(±40') N. SOUTH EDGE OF BEAVER POND IS 900'(±100') S.

C. Description of monument for corner and accessories established to perpetuate locating the position of the corner:

C-5	C-6	D-5	D-6
FD 1"x 26" PIPE; ADDED RLS CAP.	FD 1/2"x 18" RE-ROD; REPLACED W/5/8"x 34" RE-ROD, W/RLS CAP.	FD IRON; REPLACED W/5/8"x 34" RE-ROD W/RLS CAP.	PUSHED IN 1"x 10-1/2' GALV PIPE. W/RLS CAP IN COUPLING.
#11" TWIN OAK N40°E 89.1'	7" MAPLE (IN CLUMP) N55°E 43.2'	12" ASH N35°W 61.50'	11" W.OAK N55°E 270.00'
CTR BELL TEL RISER S50°E 55.0'	11" CEDAR S80°W 44.8'	3" TWIN MAPLE N05°E 57.15'	6" TWIN MAPLE N65°E 261.25'
P POLE S65°W 55.34'	10" TWIN MAPLE N70°W 40.1'	12" B.CHERRY N35°E 15.80'	17" W.OAK S88°E 219.64'
SET CED POST) W/LOC TAG) S45°E 50'	FD 1-1/4 PIPE S85°W 47.0'	10" J.PINE S30°W 53.61'	
6" MAPLE N75°W 38.9'	SET CED POST W/LOC TAG DUE E 33'		

= RLS, K.OSTLING, WIT.

Signed by Carl F. Roser 11-14-91 Date _____

Surveyor's Michigan License No. 12028

STATE OF MICHIGAN CARL F. ROSER LAND SURVEYOR No. 12028 REGISTERED LAND SURVEYOR

FORM APPROVED BY MICHIGAN ASSOCIATION OF LAND SURVEYORS, JAN. 28, 1971
REVISED MAY 14, 1975
REVISED JAN., 1983