LAND CORNER RECORDATION CERTIFICATE

Filing Requirement of Act 74, Mich. P.A. 1970

For corners in CLARE (County)

	Located In:	Corner Code ##
1. Public Land Survey	T 20N R 4W	A-4, C-4
	T ____ R ____	
	T ____ R ____	
	T ____ R ____	
2. Property Controlling	S 18 T ____ R ____	1
in Section	S 7 T ____ R ____	14
3. Miscellaneous	S ____ T ____ R ____	
Property in Sec.	S ____ T ____ R ____	

Register of Deeds Stamp & File Number

4. Lot No. _____ , Recorded Plat _____
5. Private Claims _____

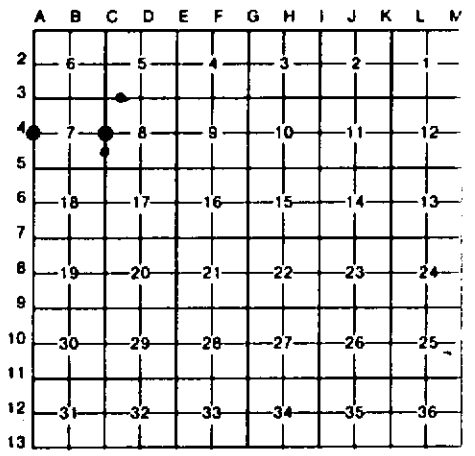

I, CARL F. ROSER, in a field survey on 01-10, 19 90, do hereby certify that under requirements of P.A. 74, Michigan P.A. of 1970, the corner points mentioned in lines 1 and 2 above were in conformance with regulations and rules therefore as required in the current manual of survey instructions of the United States Department of the Interior, Bureau of Land Management or by a decree of a Court of Law and/or that the corner points mentioned in lines 3, 4 and 5 above were in conformance with the rules of the Michigan Board of Land Surveyors or by a Decree of a Court of Law; established, re-established, monumented, re-monumented, recovered, found as expressed below:

NOTE: Not more than 4 corners, all in the same town and range, may be recorded on this certificate.

A. Description of original monument and accessories and/or subsequent restoration:

A-4 C-4 1 14

STATE OF MICHIGAN
CARL F. ROSER
LAND SURVEYOR
No. 12028
REGISTERED LAND SURVEYOR

B. Description of corner evidence found and/or method applied in restoring or reestablishing corner:

A-4	C-4	1	14
FD RLS, T.J.MUELLER 1/2" REROD OVER CONS DEPT MON, FOR N 1/4 COR SEC 7. MON SET BY PROPORTIONATE MEASUREMENT, MIDPOINT ON LINE, BETWEEN FD SEC CORS IN 1976 DEPT SURVEY BY RLS K. OSTLING. COR IS 5'± E OF CTR N-S WINDING TRAIL.	FD 1-1/2" PIPE AS FD AND ACCEPTED FOR E1/4 COR SEC 7 IN 1976 DEPT SURVEY BY RLS K. OSTLING. CTR N-S DIRT RD IS 5'± W.	FD 1-1/4" PIPE FOR NW COR OF E1/2-NW1/4 OF SEC 18 AS ESTABLISHED BY RLS K.OSTLING IN 1976 DEPT SURVEY OF SEC 7; PER STANDARD SURVEY PROCEDURE.	FD 1/2" HEX IRON FOR SE COR OF N1/2-SE1/4 SEC 7; AS SET BY STANDARD BLM INSTRUCTIONS BY RLS K.OSTLING IN 1976 DEPT SURVEY.

C. Description of monument for corner and accessories established to perpetuate locating the position of the corner:

A-4	C-4	1	14
FD 1/2"x 14" RE-ROD W/RLS CAP; OVER FD CONSERVATION DEPT MON.	FD 1-1/2" PIPE.	FD 1-1/4" PIPE & CED POST.	FD 1/2" HEX IRON; ADDED RLS CAP.
#13" W OAK N45°E 64.64'	#8" W.PINE DUE W 67.8'	#13" OAK N15°E 4.2'	#FD 12" OAK
#9" W OAK N75°E 118.19'	5" W.PINE S35°E 48.2'	5" OAK S30°E 2.7'	W/LOC TAG N85°W 50.4'
14" J PINE S50°W 59.70'	#8" W.PINE S50°W 35.5'	12" OAK S75°W 16.2'	6" W.PINE N45°E 56.7'
15"W.OAK(CLP-2) N35°W 34.36'	SET CED POST	CTR N-S 2 TRACK DUE E 12'	16" W.PINE S45°E 91.7'
SET CED POST	W/LOC TAG DUE W 33'		
W/LOC TAG DUE E 33'			
# = RLS, K OSTLING WITS.	# = RLS, K.OSTLING WITS.	# = RLS, K.OSTLING WIT.	# = RLS, K OSTLING WIT.

Signed by Carl F. Roser 11-14-91 Date _____

Surveyor's Michigan License No. 12028

FORM APPROVED BY MICHIGAN STATE BOARD OF LAND SURVEYORS, JAN. 28, 1971
REVISED MAY 14, 1975
REVISED JAN., 1983