LAND CORNER RECORDATION CERTIFICATE

Filing Requirement of Act 74, Mich. P.A. 1970

For corners in CLARE (County)

	Located In:	Corner Code ##
1. Public Land Survey	T 20N R 4W	A-1
	T ____ R ____	B-1
	T ____ R ____	C-1
	T ____ R ____	
2. Property Controlling	S 6 T ____ R ____	5
in Section	S ____ T ____ R ____	
3. Miscellaneous	S ____ T ____ R ____	
Property in Sec.	S ____ T ____ R ____	

Register of Deeds Stamp & File Number

4. Lot No. _____ , Recorded Plat _____
5. Private Claims _____

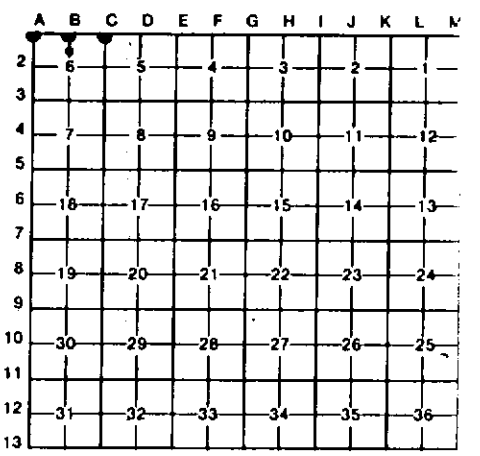

I, CARL F. ROSER, in a field survey on FEBRUARY 6, 19 89, do hereby certify that under requirements of P.A. 74, Michigan P.A. of 1970, the corner points mentioned in lines 1 and 2 above were in conformance with regulations and rules therefore as required in the current manual of survey instructions of the United States Department of the Interior, Bureau of Land Management or by a decree of a Court of Law and/or that the corner points mentioned in lines 3, 4 and 5 above were in conformance with the rules of the Michigan Board of Land Surveyors or by a Decree of a Court of Law; established, re-established, monumented, re-monumented, recovered, found as expressed below:

NOTE: Not more than 4 corners, all in the same town and range, may be recorded on this certificate.

A. Description of original monument and accessories and/or subsequent restoration:

A-1

B-1

C-1

5

B. Description of corner evidence found and/or method applied in restoring or reestablishing corner:

A-1

FD & ACCEPTED RLS,PAUL LAPHAM 1/2"REROD FOR NW COR OF SEC.6, T20N-R4W,EQUEALS NE COR.OF SEC.1,T20N-R5W(SEE LAPHAM'S SUR IN SEC.1,IN 1983).PULLED LAPHAM'S 1/2"REROD,DROVE 1"X14" PIPE DEEP & DROVE LAPHAM'S 1/2"REROD BACK INSIDE 1" PIPE.COR FALLS IN APPROX. CTR.OF E-W SAND TR.RD.-CLOSING TWP COR ON N.LINE T20N-R4&5W; ON MICH SECOND COR LINE.

B-1

ESTAB'D N1/4 COR.SEC.6(20N-R4W) @ PROPORIONATE MEASURE TO GLO SUR (U.S.RUNOUT SEC)& ON LINE BETWEEN S1/4 COR & SE COR OF SEC 31(T21N-R4W);ON MICH SECOND COR LINE. COR FALLS IN LOW WET AREA;HIGH GRD IS 60' WEST;WEST EDGE OF TOWN LINE CREEK (COURSE NNW) IS 431'E.

C-1

FD MARCUS SCHAAF(CONSERVATION DEPT.FORESTRY CHIEF & RLS-NOW DECEASED)MON(1 1/2" X 24" PIPE W/CONC.BASE)FOR CLOSING COR TO SEC'S 5&6, ON N.TWP LINE OF T20N-R4W(MICH SECOND COR LINE) SCHAAF'S PENCIL ADDITION'S TO CONS.DEPT.LEATHER BOOK OF GLO LINE NOTE'S (T20N-R4W),SHOW HE HAD U.S.B.T.STUMP(HEMLOCK 8, S50 1/2°W,30 LKG).EAST EDGE OF SWP.IS 37' EAST.

5

ESTAB.SW COR OF FRL NW 1/4 OF FRL NE1/4 OF SEC 6 PER STD. B.L.M. INSTRUCTION'S(RUN OUT SEC;PROPORTIONATE MEASURE TO GLO PLAT). E-W SINGLE STRAND SMOOTH WIRE (VERY CROOKED)IN TREE'S IS NORTH, 130'±. E-W DRIVE (TO CABIN TO EAST)IS SOUTH, 120'±; WITH GATE 170'±W.

C. Description of monument for corner and accessories established to perpetuate locating the position of the corner:

A-1

FD 1/2"X18"REROD W/RLS CAP#19433;ADDED 1"X14" PIPE.

16"OAK	S52°E	34.0'
3"R.PINE	S22°W	38.0'
9"TW.OAK	S54°W	28.4'
8"OAK	N10°W	30.6'
SET CED.POST W/LOC.TAG	SOUTH	16.5'
SW COR S-31 T21N-R4W	S89°32'W	802.68'

B-1

DR 1"X63"PIPE W/ALUMN. DNR CAP & SET CEDAR POST.

22"OAK	S74°E	45.6'
9"TW.MAPLE	S64°W	25.8'
15"TW.MAPLE	N88°W	79.0'
W.PINE	N22°W	50.1'
S1/4 COR S-31 (T21N-R4W)	S89°57'W	462.51'

C-1

FD M.SCHAAF MON;REPLACED W/1"X66"PIPE W/DNR CAP & SET CED POST.

7" ASH	S50°W	8.1'
16" CEDAR	S70°E	42.4'
23" OAK	S50°E	62.9'
11" MAPLE	N02°W	35.4'
SE COR S-31 T21N-R4W	S89°47'W	449.13'

5

DR 5/8"X34"REROD W/RLS CAP & SET CED POST W/LOC TAG

10" OAK	N30°E	21.5'
15" OAK	N66°E	36.0'
16" OAK	N40°W	6.7'

Signed by Carl F. Roser 11-14-91 Date _____

Surveyor's Michigan License No. 12028

STATE OF MICHIGAN CARL F. ROSER LAND SURVEYOR No. 12028 REGISTERED

FORM APPROVED BY MICHIGAN STATE BOARD OF LAND SURVEYORS JAN. 20, 1971 REVISED MAY 1, 1973 REVISED JAN. 1, 1983