LAND CORNER RECORDATION CERTIFICATE

Filing Requirement of Act 74, Mich. P.A. 1970

For corners in CLARE (County)

	Located In:	Corner Code ##
1. Public Land Survey	T 20N R 4W	C-2
	T ___ R ___	C-3
	T ___ R ___	
	T ___ R ___	
2. Property Controlling	S 6 T ___ R ___	9
in Section	S ___ T ___ R ___	
3. Miscellaneous	S ___ T ___ R ___	
Property in Sec.	S ___ T ___ R ___	

Register of Deeds Stamp & File Number

4. Lot No. _____ , Recorded Plat _____
5. Private Claims _____

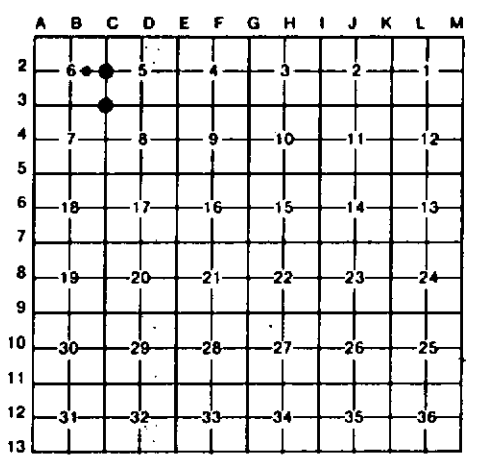

I, CARL F. ROSER, in a field survey on JUNE 22, 19 88, do hereby certify that under requirements of P.A. 74, Michigan P.A. of 1970, the corner points mentioned in lines 1 and 2 above were in conformance with regulations and rules therefore as required in the current manual of survey instructions of the United States Department of the Interior, Bureau of Land Management or by a decree of a Court of Law and/or that the corner points mentioned in lines 3, 4 and 5 above were in conformance with the rules of the Michigan Board of Land Surveyors or by a Decree of a Court of Law; established, re-established, monumented, re-monumented, recovered, found as expressed below:

NOTE: Not more than 4 corners, all in the same town and range, may be recorded on this certificate.

A. Description of original monument and accessories and/or subsequent restoration:

C-2 C-2 C-3 9

B. Description of corner evidence found and/or method applied in restoring or reestablishing corner:

C-2

RE-ESTAB'D 1/4 COR COMM TO SEC'S 5 & 6 ON LINE BETW THE NE & SE COR'S OF S-6 & AT 2640' (RECORD GLO 40 CH N OF SE S-6.) N OF SE S-6. THIS FITS RECORD GLO TIES N OF 1/4 COR OF: 1.33 CHS, STREAM 40 LKS(COURSE NW); ENTER SWP (ALREADY IN SWP-BUT CHANGES FROM ALBERS TO REGULAR SWP.) AT 18 CHS (COURSE NE & SW); CED 10" DIA (LINE TREE), FD

C-2 Cont.

13"-16" CED STUMP EXACT 22.43 CHS. THIS MILE N & S BETW SEC'S 5 & 6 IS 44' LONG TO GLO; BUT FD GLO TIES AS NOTED ABOVE, PUTS THE EXCESS ALL N OF SAID 1/4 COR TO SEC'S 5 & 6.

C-3

FD PREV DEPT COR OF RECORD; RLS KEN OSTLING FD COR HERE IN 1976. COR IS AT INTERSEC OF GRAVEL ROADS E-W-S.

9

ESTAB SW COR OF SE 1/4 OF FRL NE 1/4 OF S-6 PER STD BLM INSTRUCTIONS. N-S SINGLE STRAND SMOOTH WIRE IN TREES IS WEST 20'.

C. Description of monument for corner and accessories established to perpetuate locating the position of the corner:

C-2

DROVE 1" X 56" PIPE W/DNR ALUM CAP & SET CED POST.

9" MAPLE	N60°E	3.0'
7" MAPLE	S46°E	21.6'
13" MAPLE	S20°W	7.5'
18" MAPLE	N28°W	23.3'

C-2

C-3

FD 1" PIPE (DNR ALUM CAP BROKEN OFF)

4" W PINE	N20°E	42.2'
26" W PINE	S72°E	84.82
15" OAK	S20°E	55.1'
*15" W PINE	S22°W	81.3'
SET CED POST W/ LOC TAG	NORTH	33'

*KJO WIT.

9

DROVE 3/8" X 60" PIPE W/RLS CAP & SET CED POST W/LOC TAG.

4" MAPLE	N66°E	34.4'
5" MAPLE	S34°W	13.2'
10" TAMARACK	S82°W	20.1'

Signed by Carl F. Roser 11-14-91 Date _____

Surveyor's Michigan License No. 12028

STATE OF MICHIGAN CARL F. ROSER LAND SURVEYOR No. 12028 REGISTERED LAND SURVEYOR

FORM APPROVED BY MICHIGAN STATE BOARD OF LAND SURVEYORS JAN. 21, 1971 REVISED MAR. 11, 1975 REVISED JAN., 1983