

LAND CORNER RECORDATION CERTIFICATE
Filing Requirement of Act 74, Mich. P.A. 1970

For corners in
CLARE

(County)	Located In:	Corner Code #/
1. Public Land Survey	T <u>20N</u> R <u>4W</u>	<u>6-2</u>
	T _____ R _____	<u>6-3</u>
	T _____ R _____	_____
	T _____ R _____	_____
2. Property Controlling in Section	S <u>3</u> T _____ R _____	<u>15</u>
	S _____ T _____ R _____	_____
3. Miscellaneous Property in Sec.	S _____ T _____ R _____	_____
	S _____ T _____ R _____	_____


Register of Deeds Stamp & File Number

4. Lot No. _____, Recorded Plat _____
 5. Private Claims _____

I, CARL F. ROSER, in a field survey on MAY 26, 19 88, do hereby certify that under requirements of P.A. 74, Michigan P.A. of 1970, the corner points mentioned in lines 1 and 2 above were in conformance with regulations and rules therefore as required in the current manual of survey instructions of the United States Department of the Interior, Bureau of Land Management or by a decree of a Court of Law and/or that the corner points mentioned in lines 3, 4 and 5 above were in conformance with the rules of the Michigan Board of Land Surveyors or by a Decree of a Court of Law; established, re-established, monumented, re-monumented, recovered, found as expressed below:

NOTE: Not more than 4 corners, all in the same town and range, may be recorded on this certificate.

A. Description of original monument and accessories and/or subsequent restoration:
 6-2 6-3 6-3 CONT.

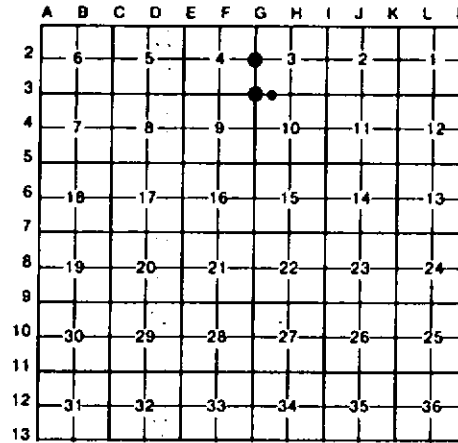


B. Description of corner evidence found and/or method applied in restoring or reestablishing corner:

<p>6-2 REESTAB'D 1/4 COR CORN TO SEC'S 3 & 4 ON LINE BETW NW & SW OF 6-3 & AT PRORATED DISTANCE TO OLD SURVEY. (RUN-OUT SEC TO NICH SECOND CORRECTION LINE). FITS GLO TIE TO "ENTER SWP" 2.50 CHAINS 6 EXACTLY; EVEN THOUGH THE MILE MEASURES 70' LONGER THAN GLO.</p>	<p>6-3 RESTORED SW COR 6-3 AT 28'-W OF PROJECTION OF OLD N-S (N-W) FN TO S (FN IS 28'E OF E 1/4 COR OF 6-3); & 178'-S OF 50 LINK STREAM, COURSE NW; AS CALLED FOR IN 1856 GLO RESURVEY LINE NOTES. COR FITS LINE ACROSS 1/4 COR'S & SEC COR'S TO N, S, & E REAL GOOD. ALSO SEE RETRACEMENT SUR MAP THIS AREA. OLD COR FN POST DOWN WITH N-W FN'S E & S ICED</p>	<p>6-3 CONT. POSTS-MOSTLY DOWN) IS S50° 44'E, 36.0'. COR ALSO FITS GLO TIES TO WEST; LV SWP (C-NE & SW) 17 CH. W, ENT SWP (C-NW & SE) 21 CH W, LV SWP (C-N & S) 26 CH W.</p>	<p>15 ESTAB'D SW COR OF E 1/2-SW 1/14 OF 6-3 PER STD B.L.M. INSTRUCTIONS.</p>
---	---	---	---

C. Description of monument for corner and accessories established to perpetuate locating the position of the corner:

<p>6-2 DR 1" X 57" GALV IR PIPE W/ DNR CAP & CED POST. 7" J PINE N28°W 13.8' 3" W PINE N60°E 65.4' 11" J PINE S50°E 13.4' 11" J PINE S75°W 17.6'</p>	<p>6-3 DR 1" X 66" GALV IR PIPE W/DNR ALUM DISK; TOP IS 2' ABOVE SWP WATER; & DR SQ TOP CED GUARD POST. 5" ASH S18°E 4.1' 7" ASH N65°W 10.3' 6" ASH N20°E 18.0' 6" ASH S65°W 25.0'</p>	<p>6-3 CONT. DR 3/8" X 5" GALV PIPE W/RLS CAP; SET CED POST W/LOC TAG. 8" ELM S30°E 54.6' 10" OAK S35°W 59.9' 11" MAPLE S85°W 50.0' SW EDGE SWP WEST 15'±10' E EDGE SWP WEST 130'± E EDGE TOWN LINE CREEK WEST 410'± E-W FN REMAINS NORTH 2'±1'</p>
---	---	---

Signed by Carl F. Roser 11-14-91
 Surveyor's Michigan License No. 12028

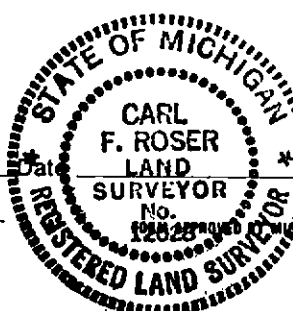

Clare County