

LAND CORNER RECORDATION CERTIFICATE
Filing Requirement of Act 74, Mich. P.A. 1970

For corners in
CLARE
(County)

Located In: _____ Corner Code 1 ~~##~~

- | | | |
|------------------------------------|-----------------------------|-------------------|
| 1. Public Land Survey | T <u>20N</u> R <u>4W</u> | <u>A-10, A-11</u> |
| | T _____ R _____ | _____ |
| | T _____ R _____ | _____ |
| | T _____ R _____ | _____ |
| 2. Property Controlling in Section | S <u>30</u> T _____ R _____ | <u>15</u> |
| | S _____ T _____ R _____ | _____ |
| 3. Miscellaneous Property in Sec. | S _____ T _____ R _____ | _____ |
| | S _____ T _____ R _____ | _____ |

Register of Deeds Stamp & File Number

4. Lot No. _____, Recorded Plat _____
 5. Private Claims _____

I, CARL F. ROSER, in a field survey on JANUARY 20, 19 92, do hereby certify that under requirements of P.A. 74, Michigan P.A. of 1970, the corner points mentioned in lines 1 and 2 above were in conformance with regulations and rules therefore as required in the current manual of survey instructions of the United States Department of the Interior, Bureau of Land Management or by a decree of a Court of Law and/or that the corner points mentioned in lines 3, 4 and 5 above were in conformance with the rules of the Michigan Board of Land Surveyors or by a Decree of a Court of Law; established, re-established, monumented, re-monumented, recovered, found as expressed below:

NOTE: Not more than 4 corners, all in the same town and range, may be recorded on this certificate.

A. Description of original monument and accessories and/or subsequent restoration:

A-10	A-11	15
------	------	----


A	B	C	D	E	F	G	H	I	J	K	L	M
2	6	5	4	3	2	1						
3												
4	7	8	9	10	11	12						
5												
6	18	17	16	15	14	13						
7												
8	19	20	21	22	23	24						
9												
10	30	29	28	27	26	25						
11												
12	31	32	33	34	35	36						
13												

B. Description of corner evidence found and/or method applied in restoring or reestablishing corner:

A-10	A-11	15
FD 1 1/2" GALV PIPE FOR W 1/4 COR SEC 30 BESIDE FD OLD 2"X41" TAPERED PIPE W/DRILLED HOLES. COR FITS LLS PAUL LAPHAM SUR OF SEC 25 & 30.	FD 3/4" IR ROD FOR SW COR SEC 30. COR FITS 3 STP'S OF LLS PAUL LAPHAM WITS. CTR E-W WINDING TRAIL 16 S. 15'±.	ACCEPTED FD 1/2" REROD FOR SE COR OF FRL W 1/2 OF FRL SW 1/4 OF SEC 30. COR FITS LLS PAUL LAPHAM SUR OF SEC. 30. CTR E-W WINDING TRAIL 16 S. 17'±.

C. Description of monument for corner and accessories established to perpetuate locating the position of the corner:

A-10	A-11	15
FD 1 1/2" GALV PIPE; ADDED RLS CAP & SET CED POST W/LOC TAG.	FD 3/4" IR ROD; ADDED DNR MON & CED POST W/LOC TAG.	FD 1/2" REROD; ADDED CED POST.
10° R OAK N20°W 20.48'	23° OAK N15°E 77.6'	6" B CHERRY S55°E 14.00'
15° R OAK DUE E 5.90'	4" B. CHERRY N65°E 76.8'	B° R PINE DUE S 46.65'
12° R OAK S25°E 8.60'	19° R PINE S20°E 112.1'	10" R PINE W/DNR LOC TAG. S55°W 57.72'
10° W OAK S40°W 30.55'		

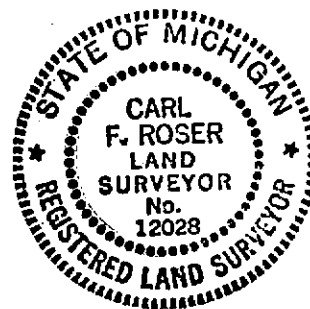

Signed by Carl F. Roser 02-24-92 Date _____
 Surveyor's Michigan License No. 12028