LAND CORNER RECORDATION CERTIFICATE

Filing Requirement of Act 74, Mich. P.A. 1970

For corners in CLARE (County)

	Located In:	Corner Code ##
1. Public Land Survey	T 20N R 4W	A-9
	T ___ R ___	B-9
	T ___ R ___	C-9
	T ___ R ___	
2. Property Controlling	S 30 T ___ R ___	1
in Section	S ___ T ___ R ___	
3. Miscellaneous	S ___ T ___ R ___	
Property in Sec.	S ___ T ___ R ___	

Register of Deeds Stamp & File Number

4. Lot No. _____ , Recorded Plat _____
5. Private Claims _____

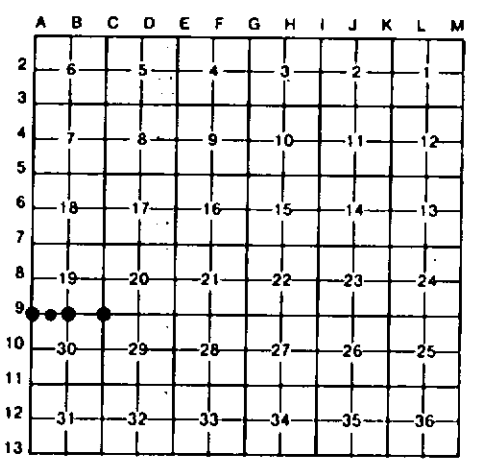

I, CARL F. ROSER, in a field survey on JANUARY 18, 19 92, do hereby certify that under requirements of P.A. 74, Michigan P.A. of 1970, the corner points mentioned in lines 1 and 2 above were in conformance with regulations and rules therefore as required in the current manual of survey instructions of the United States Department of the Interior, Bureau of Land Management or by a decree of a Court of Law and/or that the corner points mentioned in lines 3, 4 and 5 above were in conformance with the rules of the Michigan Board of Land Surveyors or by a Decree of a Court of Law; established, re-established, monumented, re-monumented, recovered, found as expressed below:

NOTE: Not more than 4 corners, all in the same town and range, may be recorded on this certificate.

A. Description of original monument and accessories and/or subsequent restoration:

A-9 B-9 C-9 1

B. Description of corner evidence found and/or method applied in restoring or reestablishing corner:

A-9
ACCEPTED FD IR FOR NW COR SEC 30. COR IS IN APPROX CTR E-W GR RD.

B-9
RE-MONUMENTED N1/4 COR SEC 30 FROM FD 2 LLS, PAUL LAPHAM WITS. COR FITS LAPHAM SUR OF SEC 30. CTR E-W GR RD IS N. 9'±.

C-9
FD 3/4' IRON ROD FOR NE COR SEC 30. COR FITS 3 WITS BY LLS, PAUL LAPHAM. COR FITS LAPHAM SUR OF SEC'S 20 & 30. CTR N-S DIRT RD IS E 6'±. COR IS IN LINE W/APPROX CTR DIRT RD TO W.

1
ESTAB'D NW COR OF E1/2 OF FRL NW1/4 SEC. 30 ON LINE & PRORATED DIST TO G.L.O. BTWN SEC. COR W & 1/4 COR E; (RUN-OUT SEC). CTR OF E-W GRV RD IS 5'± N. DROVE 1"X14" PIPE, S01°50'02"E, 651.65'; POINT ON W LINE OF E1/2 FRL NW 1/4 SEC. 30 (STATE B'DRY).

C. Description of monument for corner and accessories established to perpetuate locating the position of the corner:

A-9
FD 3/4"X12" IRON ROD; ADDED RLS CAP.

8" W OAK	N30°W	31.38'
14" W OAK	N40°E	61.83'
POWER POLE	S40°E	65.80'
9" W PINE	S35°W	32.55'
SET CED POST W/ LOC TAG.	DUE N	33'

B-9
DROVE 5/8"X34" REROD W/RLS CAP; PER P. LAPHAM WITS.

*16" R OAK IN CLP 2	N60°W	71.2'
5" W OAK	N25°E	36.9'
*POWER POLE	N45°E	95.41'
8" MAPLE	S35°E	16.0'
SET CED POST W/ LOC TAG	DUE N	33'

* = LS, P. LAPHAM WIT.

C-9
FD 3/4"X16" IRON ROD; ADDED RLS CAP.

* 9" R. OAK	N50°E	33.34'
*15" R. OAK	S85°E	25.16'
*17" R. OAK	S25°W	35.69'
SET CED POST W/ LOC TAG BESIDE FD 1/2" IRON WITH RLS CAP	DUE E	33'

*LS, P. LAPHAM B.T.

1
DROVE 5/8"X34" REROD W/RLS CAP.

7" OAK	N45°W	36.45'
7" OAK	N05°W	28.58'
POWER POLE	N55°E	103.42'
15" OAK	S55°E	48.98'
SET CED POST W/LOC TAG.	DUE N	33'

Signed by Carl F. Roser 02-24-92 Date _____

Surveyor's Michigan License No. 12028

STATE OF MICHIGAN CARL F. ROSER LAND SURVEYOR No. 12028 REGISTERED LAND SURVEYOR

FORM APPROVED BY MICHIGAN STATE BOARD OF LAND SURVEYORS, JAN. 28, 1971 REVISED MAY 14, 1975 REVISED JAN., 1983