LAND CORNER RECORDATION CERTIFICATE

Filing Requirement of Act 74, Mich. P.A. 1970

For corners in CLARE (County)

	Located In:	Corner Code #/
1. Public Land Survey	T 20N R 4W	H-1, H-2
	T ___ R ___	
	T ___ R ___	
	T ___ R ___	
2. Property Controlling	S 3 T ___ R ___	9
in Section	S ___ T ___ R ___	
3. Miscellaneous	S ___ T ___ R ___	
Property in Sec.	S ___ T ___ R ___	

Register of Deeds Stamp & File Number

4. Lot No. _____ , Recorded Plat _____
5. Private Claims _____

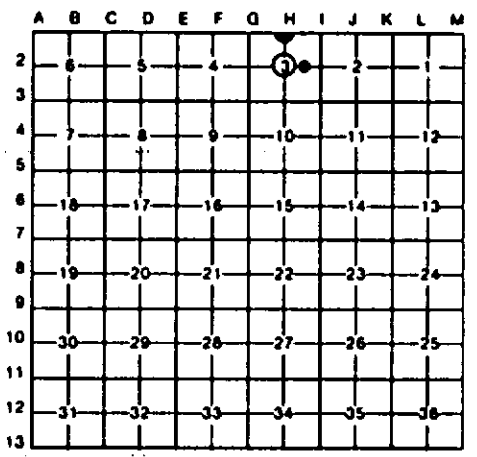

I, C.F.ROSER, in a field survey on MAY 7, 19 92, do hereby certify that under requirements of P.A. 74, Michigan P.A. of 1970, the corner points mentioned in lines 1 and 2 above were in conformance with regulations and rules therefore as required in the current manual of survey instructions of the United States Department of the Interior, Bureau of Land Management or by a decree of a Court of Law and/or that the corner points mentioned in lines 3, 4 and 5 above were in conformance with the rules of the Michigan Board of Land Surveyors or by a Decree of a Court of Law; established, re-established, monumented, re-monumented, recovered, found as expressed below:

NOTE: Not more than 4 corners, all in the same town and range, may be recorded on this certificate.

A. Description of original monument and accessories and/or subsequent restoration:

H-1

H-2

9

B. Description of corner evidence found and/or method applied in restoring or reestablishing corner:

H-1

FD. CONSERVATION DEPT. MON. FOR N1/4 COR. SEC. 3, T20N-R4W K.OSTLING ESTABLISHED THIS COR BY PROPORTIONATE MEASURMENT BETWEEN SECTION CORNERS OF SEC. 3 IN 1966.

H-2

ESTABLISHED CTR OF SEC. 3, T20N-R4W AT INTERSECTION OF 1/4 LINES. E-W SMOOTH WIRE IN TREES IS 2' NORTH. END OF TRAVERSE FROM E. IS 33' NORTH.

9

ESTABLISHED NW COR OF NE1/4 OF SE1/4 OF SEC 3, T20N-R4W PER STANDARD BLM INSTRUCTIONS. FD STATE OF MICHIGAN BRASS CAPPED MON AS SET IN ERROR BY W.S.MOORE IN 1957, S53°34'E, 38.94'. EDGE OF WILDLIFE FLOODING IS 335'± 30' EAST.

C. Description of monument for corner and accessories established to perpetuate locating the position of the corner:

H-1

FD CONSERVATION DEPT MON AND ADDED CEDAR POST.

9" CEDAR	S80°E	37.7'
10"MAPLE	S75°E	21.4'
#10"TRI MAPLE	S45°E	17.7'
10" TW MAPLE	S35°W	21.3'

H-2

DROVE 5/8"x 34" REROD W/LS CAP SET CEDAR POST W/LOC TAG.

7"BALSAM	N10°W	27.8'
11"MAPLE	S45°E	37.2'
10"MAPLE	S15°W	10.1'
9" MAPLE	S50°W	35.1'

9

DROVE 5/8"x 34" REROD W/LS CAP & SET CEDAR POST W/LOC TAG.

6"TW.MAPLE	N60°W	5.9'
8" MAPLE	S55°E	23.5'
7" MAPLE	S15°E	10.1'
10" MAPLE	S75°W	21.0'

STATE OF MICHIGAN
CARL F. ROSER
LAND SURVEYOR
No. 12028
REGISTERED LAND SURVEYOR

#= RLS, K.OSTLING, MIT.

Signed by Carl F. Roser Date 3-29-94

Surveyor's Michigan License No. 12028

FORM APPROVED BY MICHIGAN STATE BOARD OF LAND SURVEYORS, JAN. 28, 1971
REVISED MAY 14, 1975
REVISED JAN., 1983