

SURVEY & REMONUMENTATION COMMISSION
APR 06 1995

LAND CORNER RECORDATION CERTIFICATE
Filing Requirement of Act 74, Mich. P.A. 1970

RECEIVED
 E I A
 # 62-94
 94 NOV 28 AM 10:36

REGISTER OF DEEDS
 CLARE COUNTY
 DONNA M. CARR

For corners CLARE (County) Located In: _____ Corner Code -# _____

1. Public Land Survey
 T 20N R 6W M-7
 T 20N R 5W **A-7** (COMMON CORNER)
 T _____ R _____
 T _____ R _____

2. Property Controlling in Section
 S _____ T _____ R _____
 S _____ T _____ R _____

3. Miscellaneous Property in Sec.
 S _____ T _____ R _____
 S _____ T _____ R _____

4. Lot No. _____, Recorded Plat _____

5. Private Claims _____

Register of Deeds Stamp & File Number

	A	B	C	D	E	F	G	H	I	J	K	L	M
2	6	5	4	3	2	1							
3													
4	7	8	9	10	11	12							
5													
6	18	17	16	15	14	13							
7													
8	19	20	21	22	23	24							
9													
10	30	29	28	27	26	25							
11													
12	31	32	33	34	35	36							
13													

I, MARK R. ROBISON, in a field survey on NOVEMBER, 19 94, do hereby certify that under requirements of P.A. 74, Michigan P.A. of 1970, the corner points mentioned in lines 1 and 2 above were in conformance with regulations and rules therefore as required in the current manual of survey instructions of the United States Department of the Interior, Bureau of Land Management or by a decree of a Court of Law and/or that the corner points mentioned in lines 3, 4 and 5 above were in conformance with the rules of the Michigan Board of Land Surveyors or by a Decree of a Court of Law, established, re-established, monumented, re-monumented, recovered, found as expressed below:

NOTE: Not more than 4 corners, all in the same town and range, may be recorded on this certificate.

- A. Description of original monument and accessories and/or subsequent restoration:
- 1856 COLEMAN, G.L.O. PG.517
 POST. (20" WHITE PINE FOR COR. IS GONE)
 WIT.-(1)SPRUCE 8" N50°W 327 LKS.
 - 8-16-33 A. JOHNSON, C.S.R. L.2-PG.53
 WIT.-(2)Y. PINE 20" S26°30'E 189 LKS.
 (3)Y. PINE 18" N52°W 241 LKS.
 - NO RECORDED SURVEYS.
 - 7-28-76 OSTLING, L.C.R.C. #279
 FOUND 3/4" BAR, SET DNR MONUMENT
 WIT.-(4)12" R. OAK N64°E 66.5'
 (5)24" R. PINE N28°W 164.75'


- B. Description of corner evidence found and/or method applied in restoring or reestablishing corner:
- FOUND DNR MONUMENT. 3 1/4" CAP ON 1" PIPE IN GOOD CONDITION. FOUND WITNESSES # 4 & 5.
 EXCAVATED DOWN 2' AROUND MONUMENT. NO OTHER EVIDENCE.

This Corner established in Clare County Remonumentation Program.
 See dossier for detailed report.

- C. Description of monument for corner and accessories established to perpetuate locating the position of the corner:

ACCEPTED DNR MONUMENT 3 1/4" CAP ON 1" PIPE:
 WITNESSES:
 N64°E 66.5' 16" R. OAK - NAIL & TAG (4)
 N28°W 164.87' 28" R. PINE - NAIL & TAG (5)
 S35°E 118.7' 32" STUMP WITH CLUSTER OF 3^d TREES - NAIL & TAG
 S45°W 43.5' 18" J. PINE - NAIL & TAG

APPROVED LAND CORNER
 P.A. 945 of 1990
 Clare County
 Chairman Paul B. Poppen
 Date Nov 23, 1994

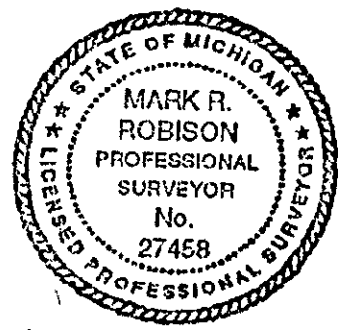

Signed by Mark R. Robison Date 11-23-94
 Surveyor's Michigan License No. 27458