

NOV 18 1997

CLARE COUNTY REMONUMENTATION

COMMISSION

LAND CORNER RECORDATION CERTIFICATE
Filing Requirement of Act 74, Mich. P.A. 1970

RECEIVED

For corners in

CLARE
(County)

Located In:

Corner Code #

1. Public Land Survey

T20N	R 5W	A-13
T19N	R 5W	A-1
T20N	R 6W	M-13
T19N	R 6W	M-1
S	T	R
S	T	R
S	T	R
S	T	R

2. Property Controlling in Section

3. Miscellaneous Property in Sec.

4. Lot No. _____, Recorded Plat _____

5. Private Claims _____

#205-97
97 OCT 15 AM 10:50

REGISTER OF DEEDS
CLARE COUNTY
CAROL A. MCAULAY

SUMMERFIELD
GREENWOOD
WINTERFIELD
REDDING

Register of Deeds Stamp & File Number

I, MARK R. ROBISON, in a field survey on July 1, 19 97 do hereby state that under requirements of P.A. 74, Michigan P.A. of 1970, the corner points mentioned in lines 1 and 2 above were in conformance with regulations and rules therefore as required in the current manual of survey instructions of the United States Department of the Interior, Bureau of Land Management or by a decree of a Court of Law and/or that the corner points mentioned in lines 3, 4 and 5 above were in conformance with the rules of the Michigan Board of Land Surveyors or by a Decree of a Court of Law; established, re-established, monumented, recovered, found as expressed below.

NOTE: Not more than 2 corners, all in the same town and range, may be recorded on this certificate.

A	B	C	D	E	F	G	H	I	J	K	L	M
2	6	5	4	3	2	1						
4	7	8	9	10	11	12						
6	10	17	16	15	14	13						
8	19	20	21	22	23	24						
10	30	29	28	27	26	25						
12	31	32	33	34	35	36						
13												

A. Description of original monument and accessories and/or subsequent restoration:

1838 Nicholson
Set Post 77.60 from East
Wit-Pitch Pine 10" S13W 17
Pitch Pine 19" N66E 43

3-1935 Johnson CSR 2-71
Wit-Pine Stump 24" S67E 120
Oak 3" N59W 131

12-15-76 Ostling LCRC#276
Fd 2" pipe as restored by M. Schaaf in survey in T20-5W. Fits U.S. notes West
Set D.N.R. Mon in place of 2" pipe & red top Post
Wit-6" R. Pine N20E 20.45
6" R. Oak S32E 24.8
4" J. Pine S46W 5.0

B. Description of corner evidence found and/or method applied in restoring or reestablishing corner:

Found D.N.R. Monument and all witnesses.

See dossier for detailed report.


APPROVED LAND CORNER
P.A. 345 of 1990
Clare County

Chairman Paul B. Leph
Date 9-23-97

C. Description of monument for corner and accessories established to perpetuate locating the position of the corner:

Accepted D.N.R. Monument as Clare County Remonumentation Monument. Accepted as best available evidence of the accepted position of the corner.

Witnesses:
N20E 20.45', N&T, 12" R. Pine (OBT)
S32E 24.80', N&T, 7" R. Oak (OBT)
S46W 5.00', N&T, 7" J. Pine (OBT)
S71E 9.10', N&T, 6" J. Pine
S17E 12.70', N&T 5" J. Pine

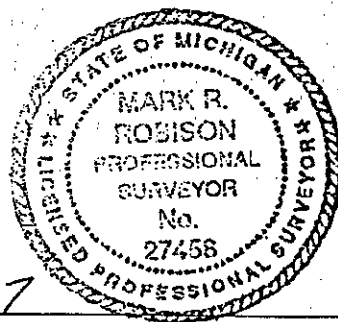

Signed by Mark R. Robison
Surveyor's Michigan License No. 27458

Date 10-01-97