

MAR 24 2000

SECTION

LAND CORNER RECORDATION CERTIFICATE
Filing Requirement of Act 74, Mich. P.A. 1970
Clare County Remonumentation

For Corners in
Clare

(County)	Located In:	Corner Code#:
1. Public Land Survey	T. <u>20N</u> R. <u>5W</u>	<u>B-7</u>
	T. _____ R. _____	_____
	T. _____ R. _____	_____
2. Public Controlling in Section	S. _____ T. _____ R. _____	_____
	S. _____ T. _____ R. _____	_____
3. Miscellaneous Property in Section	S. _____ T. _____ R. _____	_____
	S. _____ T. _____ R. _____	_____
4. Lot No. _____, Recorded Plat		
5. Private Claims		

199900007872
Filed for Record in
CLARE COUNTY MICHIGAN
CAROL MCAULAY
On 09-20-1999 At 11:15 am.
LAND CORNER 9.00
OR Liber 2 Page 36 - 36

Instrument Liber Page
199900007872 OR 2 36

Register of Deeds Stamp & File Number

I, Mark R. Robison, in a field survey on July 19, 1999, do hereby certify that under requirements of P.A. 74, Michigan P.A. of 1970, the corner points mentioned in lines 1 and 2 above were in conformance with regulations and rules therefore as required in the current manual of survey instructions of the United States Department of the Interior, Bureau of Land Management or by a decree of a Court of Law and/or that the corner points mentioned in lines 3, 4 and 5 above were in conformance with the rules of the Michigan Board of Land Surveyors or by a Decree of a Court of Law, established, re-established, monumented, re-monumented, recovered, found as expressed below.

	A	B	C	D	E	F	G	H	I	J	K	L	M
1													
2	6	5	4	3	2	1							
3													
4	7	8	9	10	11	12							
5													
6	18	17	16	15	14	13							
7													
8	19	20	21	22	23	24							
9													
10	30	29	28	27	26	25							
11													
12	31	32	33	34	35	36							
13													

NOTE: Not more than 2 corners, all in the same town and range, may be recorded on this certificate.

A. Description of original monument and accessories and/or subsequent restoration:

1856 Adair
Set Qr. Sec. Post
S. Pine 8" S32E 163
S. Pine 7" N62W 55

8-10-92 Roser LCRC #723 & DNR Plan R-18-AB
Fd old rusty 2" pipe for S1/4 Cor. S-18
Cor. Wit & used by others.
N05W 16.10 11" R. Pine
N50E 34.60 14" B. Oak
S40E 31.88 12" B. Oak
N80W 12.54 11" R. Pine
Meas. East 2636.15
Meas. West 2317.21 (GLO 2346.3)

APPROVED LAND CORNER
P.A. 345 of 1990
Clare County

Chairman Paul D. Lyle
Date 9-15-99

B. Description of corner evidence found and/or method applied in restoring or re-establishing corner:

See dossier for detailed report.

Found DNR monument and all 1992 witnesses. DNR cedar post is 1 1/2 feet N.W.


C. Description of monument for corner and accessories established to perpetuate locating the position of the corner:

Accepted DNR monument as Clare Co. Remon Corner. Accepted as best available evidence of the accepted position of the corner.

Witnesses:

N50°E 34.61 Fd spike in 16" B. Oak (OBT)
S40°E 31.90 Fd spike in 12" B. Oak (OBT)
N80°W 12.54 Fd spike in 14" R. Pine (OBT)
N05°W 16.10 Fd spike in 12" R. Pine (OBT)

Signed by Mark R. Robison
Surveyor's Michigan License No. 27458

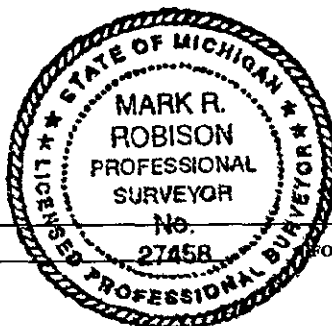

Date 9-15-99