

**SURVEY &
REMONUMENTATION**

JAN 23 2001

**LAND CORNER RECORDATION CERTIFICATE
Filing Requirement of Act 74, Mich. P.A. 1970
Clare County Remonumentation**

SECTION

For Corners in
Clare

(County)

Located In:

Corner Code#:

- | | | |
|---|----------------------------|------------|
| 1. Public Land Survey | T. <u>20N</u> R. <u>5W</u> | <u>B-9</u> |
| | T. _____ R. _____ | _____ |
| | T. _____ R. _____ | _____ |
| 2. Public Controlling
in Section | S. _____ T. _____ R. _____ | _____ |
| | S. _____ T. _____ R. _____ | _____ |
| 3. Miscellaneous
Property in Section | S. _____ T. _____ R. _____ | _____ |
| | S. _____ T. _____ R. _____ | _____ |
| 4. Lot No. _____, Recorded Plat _____ | | |
| 5. Private Claims _____ | | |

200000010164
Filed for Record in
CLARE COUNTY MICHIGAN
CAROL MCAULAY
On 12-15-2000 At 07:44 am.
LAND CORNER 9.00
OR Liber 2 Page 287 - 287

Instrument Liber Page
200000010164 OR 2 287

492-00

Register of Deeds Stamp & File Number

I, Mark R. Robison, in a field survey on November 9, 2000, do hereby certify that under requirements of P.A. 74, Michigan P.A. of 1970, the corner points mentioned in lines 1 and 2 above were in conformance with regulations and rules therefore as required in the current manual of survey instructions of the United States Department of the Interior, Bureau of Land Management or by a decree of a Court of Law and/or that the corner points mentioned in lines 3, 4 and 5 above were in conformance with the rules of the Michigan Board of Land Surveyors or by a Decree of a Court of Law, established, re-established, monumented, re-monumented, recovered, found as expressed below.

1	A	B	C	D	E	F	G	H	I	J	K	L	M
2	6	5	4	3	2	1							
3													
4	7	8	9	10	11	12							
5													
6	18	17	16	15	14	13							
7													
8	19	20	21	22	23	24							
9													
10	30	29	28	27	26	25							
11													
12	31	32	33	34	35	36							
13													

NOTE: Not more than 2 corners, all in the same town and range, may be recorded on this certificate.

A. Description of original monument and accessories and/or subsequent restoration:

GLO, Adair, 1856
Set Post
S. Pine 10" N88 1/4W, 9.32 LINKS
Y. Pine 18" S28°W, 45 LINKS

Survey, Roser, 1994, Unrecorded
Set D.N.R Monument S.P.M. to U.S.
B-9 to A-9, 2432.64
B-9 to C-9, 2608.03

CSR, Johnson, 1935
Bk 2. Pg. 70
Pine N.E.
A-9 to C-9, 77.50 chains

LCRC, Roser, 1992
LCRC #722 - 92
Set D.N.R. monument and post by
S.P.M. Int. of trials W & S is 31 feet
North and 33 feet West.
Four witnesses

APPROVED LAND CORNER
P.A. 345 of 1990
Clare County
Chairman Paul A. Sopher
Date 12-13-00


B. Description of corner evidence found and/or method applied in restoring or re-establishing corner.

Found DNR monument and four 1992 witnesses. Verified DNR distances to A-9 and C-9 by GPS. Accepted DNR monument as best available evidence of the position of the corner.

C. Description of monument for corner and accessories established to perpetuate locating the position of the corner:

Accepted DNR Monument as Clare County Remonumentation Monument.

Witnesses:
N10°W, 6.15' - Fd spike in 7" R. Pine (OBT)
N75°E, 19.42' - Fd spike in 5" R. Pine (OBT)
S35°E, 19.68' - Fd spike in 9" R. Pine (OBT)
S15°E, 8.8' - Fd spike in 6" R. Pine (OBT)

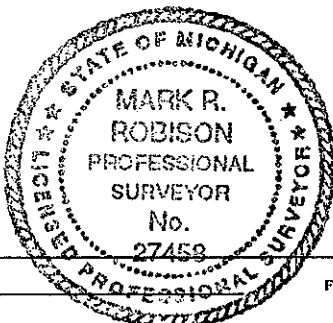

Signed by Mark R. Robison
Surveyor's Michigan License No. 27458

Date 12/14/2000