

**MAR 24 2000**

**SECTION**

**LAND CORNER RECORDATION CERTIFICATE**  
**Filing Requirement of Act 74, Mich. P.A. 1970**  
**Clare County Remonumentation**

For Corners in  
Clare  
 (County)

	Located In:	Corner Code#:
1. Public Land Survey	T. <u>20</u> R. <u>5W</u>	<u>C-5</u>
	T. _____ R. _____	_____
	T. _____ R. _____	_____
2. Public Controlling in Section	S. _____ T. _____ R. _____	_____
	S. _____ T. _____ R. _____	_____
3. Miscellaneous Property in Section	S. _____ T. _____ R. _____	_____
	S. _____ T. _____ R. _____	_____
4. Lot No. _____, Recorded Plat		
5. Private Claims		

199900007869  
 Filed for Record in  
 CLARE COUNTY MICHIGAN  
 CAROL MCAULAY  
 On 09-20-1999 At 11:15 am.  
 LAND CORNER 9.00  
 OR Liber 2 Page 33 - 33

Instrument Liber Page  
 199900007869 OR 2 33

**Register of Deeds Stamp & File Number**

I, Mark R. Robison, in a field survey on July 16, 1999, do hereby certify that under requirements of P.A. 74, Michigan P.A. of 1970, the corner points mentioned in lines 1 and 2 above were in conformance with regulations and rules therefore as required in the current manual of survey instructions of the United States Department of the Interior, Bureau of Land Management or by a decree of a Court of Law and/or that the corner points mentioned in lines 3, 4 and 5 above were in conformance with the rules of the Michigan Board of Land Surveyors or by a Decree of a Court of Law, established, re-established, monumented, re-monumented, recovered, found as expressed below.

1	A	B	C	D	E	F	G	H	I	J	K	L	M
2	6	5	4	3	2	1							
3													
4	7	8	9	10	11	12							
5													
6	18	17	16	15	14	13							
7													
8	19	20	21	22	23	24							
9													
10	30	29	28	27	26	25							
11													
12	31	32	33	34	35	36							
13													

**NOTE: Not more than 2 corners, all in the same town and range, may be recorded on this certificate.**

**A. Description of original monument and accessories and/or subsequent restoration:**

1856 Adair  
 Set Post cor Sec 7-8-17 & 18  
 Y. Pine 24 S79E 612 links  
 Y. Pine 36" S3W 1029 links

1914 Johnson, Bk 6 116 & 117  
 Meas. West 76.48 1/2 to Sec. Cor.  
 Meas. East 80.09 1/2 to Sec. Cor.

1933 Johnson, Bk 2 P-50-51  
 Oak 12" S 0.6  
 Oak 16" S74-30E 95

1982 Wilcox, LCRC #422  
 Fd pitcher pump buried upright  
 N03W 65.14 10" Oak  
 S27W 32.39 10" J. Pine  
 S35E 66.12 10" Oak  
 N47E 23.93 PK in intersection

1990 Roser, LCRC #689  
 Drove 1" x 36" Galv. Pipe w/Alum DNR cap in Fd. Bottom part of pitcher pump. Set. ced. post  
 N10°W 65.11 15" B. Oak  
 S50E 57.75 14" B. Oak  
 S30E 56.94 11" R. Pine  
 S10W 34.28 7" W. Pine  
 S50W 63.79 12" R. Pine

1994 Roser, DNR Plan No. R-18-AB  
 Meas. S89-49-17W 2638.43  
 Meas. S89-43-54E 2635.77  
 Meas. S00-29-52W 2645.16

**APPROVED LAND CORNER**  
 P.A. 345 of 1990  
 Clare County  
 Chairman Paul S. Lapham  
 Date 9-15-99


**B. Description of corner evidence found and/or method applied in restoring or re-establishing corner:**  
 See dossier for detailed report.

Fd D.N.R. Monument with Ced. Post on S.E. side and all DNR witnesses. Did not find 1982 witnesses.

**C. Description of monument for corner and accessories established to perpetuate locating the position of the corner:**  
 Accepted 4" capped D.N.R. Monument for Clare Co. Remon corner. Accepted as best available evidence of the accepted position of the corner.

Witnesses:  
 S50E 57.75 Spike in 15" B. Oak (OBT)  
 S30E 57.06 Spike in 12" R. Pine (OBT)  
 S10W 34.28 Spike in 11" W. Pine (OBT)  
 S50W 63.70 Spike in 13" R. Pine (OBT)  
 N12W 66.65 N & T in 8" Oak

Signed by Mark R. Robison  
 Surveyor's Michigan License No. 27458

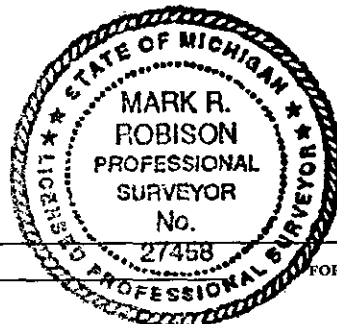

Date 9-15-99