

NOV 18 1997

CLARE COUNTY REMONUMENTATION

COMMISSION

LAND CORNER RECORDATION CERTIFICATE
Filing Requirement of Act 74, Mich. P.A. 1970

RECEIVED
208-47
97 OCT 15 AM 10:50

REGISTER OF DEEDS
CLARE COUNTY
CAROL A. McAULAY

SUMMERFIELD
GREENWOOD

Register of Deeds Stamp & File Number

For corners in

CLARE
(County)

Located In:

Corner Code #

1. Public Land Survey

T20N	R 5W	D-13
T19N	R 5W	D-1
T	R	
T	R	
S	T	R
S	T	R
S	T	R
S	T	R

2. Property Controlling in Section

3. Miscellaneous Property in Sec.

4. Lot No. _____, Recorded Plat _____

5. Private Claims _____

I, MARK R. ROBISON, in a field survey on July 1, 1997 do hereby state that under requirements of P.A. 74, Michigan P.A. of 1970, the corner points mentioned in lines 1 and 2 above were in conformance with regulations and rules therefore as required in the current manual of survey instructions of the United States Department of the Interior, Bureau of Land Management or by a decree of a Court of Law and /or that the corner points mentioned in lines 3, 4 and 5 above were in conformance with the rules of the Michigan Board of Land Surveyors or by a Decree of a Court of Law; established, re-established, monumented, recovered, found as expressed below:

NOTE: Not more than 2 corners, all in the same town and range, may be recorded on this certificate.

	A	B	C	D	E	F	G	H	I	J	K	L	M
1													
2	6		5		4		3		2		1		
3													
4	7		8		9		10		11		12		
5													
6	18		17		16		15		14		13		
7													
8	19		20		21		22		23		24		
9													
10	30		29		28		27		26		25		
11													
12	31		32		33		34		35		36		
13													

A. Description of original monument and accessories and/or subsequent restoration:

1838 Nicholson
Set 1/4 Sec Post
Wit.-W. Pine 14" N37E 3.25

04-05-73 Sedgman LCRC#97
Wit.-same as above

1-12-73 Sedgman (132) unrecorded
Fd. 2" Pipe
Wit.-S20W 67.50 8" Pine
S70W 96.33 6" Pine
N20E 111.20 12" Pine

08-10-92 Roser LCRC#701
Fd. M. Schaaf pipe for N 1/4 Cor Sec 5
Schaaf notes say "Fd NE BT(GLO) stump"
(W. Pine 14 N37E 3.25 ch's.) The fd
1 1/2" Pipe is the same physical point
as recovered and used by RLS Sedgman
(Paul Lapham & Assoc) in his Cert Sur
of NE 1/4 Se 5 Jan 1973.

Drove 1" x 96" Galv. Pipe w/ Alum
D.N.R. Cap and Set Ced Post.
Wit.-12" J. Pine N25E 111.13 (OBT)
12" J. Pine S25W 67.53 (OBT)
8" J. Pine S75W 96.33 (OBT)
8" Maple N25W 134.04

B. Description of corner evidence found and/or method applied in restoring or reestablishing corner:

Found D.N.R. Monument Cap on 1" Pipe. Also found 1 1/2" x 20" old pipe along side. Found all D.N.R. witnesses.

See dossier for detailed report.

APPROVED LAND CORNER
P.A. 345 of 1990
Clare County


Chairman Paul B. Lapham

Date 9-23-97

C. Description of monument for corner and accessories established to perpetuate locating the position of the corner:

Accepted D.N.R. Monument as Clare County Monument. Accepted as perpetuation of the original corner.

Witnesses:
N28E 111.3', N&T, 16" J. Pine (OBT)
N24W 134.3', N&T, 10" Maple (OBT)
N21W 67.4', N&T, 14" J. Pine (OBT)
S85W 96.3', N&T 10" J. Pine (OBT)
S74E 88.7', N&T 6" Maple

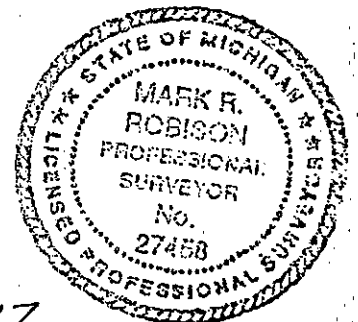

Signed by Mark R. Robison
Surveyor's Michigan License No. 27458

Date 10-01-97