

NOV 18 1997

COMMISSION

CLARE COUNTY REMONUMENTATION

LAND CORNER RECORDATION CERTIFICATE
Filing Requirement of Act 74, Mich. P.A. 1970

RECEIVED

#210-97
97 OCT 15 AM 10:50

REGISTER OF DEEDS
CLARE COUNTY
CAROL A. McAULAY
SUMMERFIELD
GREENWOOD

Register of Deeds Stamp & File Number

For corners in

CLARE

(County)

Located In:

Corner Code #

1. Public Land Survey

T20N R5W

F-13

T19N R5W

F-1

2. Property Controlling in Section

S T R

3. Miscellaneous Property in Sec.

S T R

4. Lot No. _____, Recorded Plat _____
5. Private Claims _____

I, MARK R. ROBISON, in a field survey on July 1, 19 97 do hereby state that under requirements of P.A. 74, Michigan P.A. of 1970, the corner points mentioned in lines 1 and 2 above were in conformance with regulations and rules therefore as required in the current manual of survey instructions of the United States Department of the Interior, Bureau of Land Management or by a decree of a Court of Law and /or that the corner points mentioned in lines 3, 4 and 5 above were in conformance with the rules of the Michigan Board of Land Surveyors or by a Decree of a Court of Law; established, re-established, monumented, recovered, found as expressed below:

NOTE: Not more than 2 corners, all in the same town and range, may be recorded on this certificate.

	A	B	C	D	E	F	G	H	I	J	K	L	M
1													
2		6		5		4		3		2		1	
3													
4		7		8		9		10		11		12	
5													
6		18		17		16		15		14		13	
7													
8		19		20		21		22		23		24	
9													
10		30		29		28		27		26		25	
11													
12		31		32		33		34		35		36	
13													

A. Description of original monument and accessories and/or subsequent restoration:

1838 Nicholson
Set 1/4 Sec Post
Wit-Cedar N17W 10
Cedar N27 1/2E 12

8-10-92 Roser LCRC#711
Monumented the S 1/4 Cor S-33 midway & on line between fd SW & SE Cor S-33. Cor falls in SW edge of 13" Ash stump. Ctr old E-W built up trail is 17' South. Wit-Drove 1" x 70" Galv Pipe w/Alum D.N.R. Cap & set Ced Post
4" Maple N25W 24.6'
8" Cedar N35E 58.0'
6" Maple S25E 31.2'
6" Ash S80W 12.9'

B. Description of corner evidence found and/or method applied in restoring or reestablishing corner:

Found D.N.R. Monument and witnesses.

See dossier for detailed report.

APPROVED LAND CORNER
P.A. 345 of 1990

Clare County

Chairman Paul A. Topp


Date 9-23-97

C. Description of monument for corner and accessories established to perpetuate locating the position of the corner:

Accepted D.N.R. Monument as Clare County Remonumentation Monument. Accepted as the best position for the corner using proper resurvey procedures.

Witnesses:

- N25W 24.60', N&T, 5" Maple (OBT)
- N35E 58.00', N&T, 9" Cedar (OBT)
- S25E 31.20', N&T, 7" Maple (OBT)
- S80W 12.90', N&T, 6" Ash (OBT)

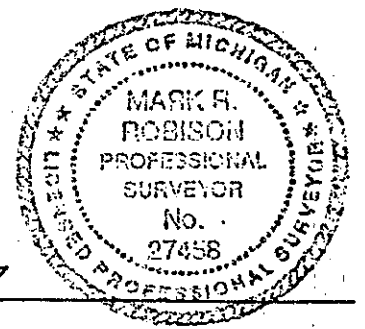

Signed by Mark R. Robison
Surveyor's Michigan License No. 27458

Date 10-01-97