

SURVEY & REMONUMENTATION

MAR 24 2000

SECTION

**LAND CORNER RECORDATION CERTIFICATE
Filing Requirement of Act 74, Mich. P.A. 1970
Clare County Remonumentation**

For Corners in
Clare

(County)	Located In:	Corner Code#:
1. Public Land Survey	T. <u>20N</u> R. <u>5W</u>	<u>H-5</u>
	T. _____ R. _____	_____
	T. _____ R. _____	_____
2. Public Controlling in Section	S. _____ T. _____ R. _____	_____
	S. _____ T. _____ R. _____	_____
3. Miscellaneous Property in Section	S. _____ T. _____ R. _____	_____
	S. _____ T. _____ R. _____	_____
4. Lot No. _____, Recorded Plat _____		
5. Private Claims _____		

199900007864
Filed for Record in
CLARE COUNTY MICHIGAN
CAROL MCAULAY
On 09-20-1999 At 11:15 am.
LAND CORNER 9.00
OR Liber 2 Page 28 - 28

Instrument Liber Page
199900007864 OR 2 28

Register of Deeds Stamp & File Number

I, Mark R. Robison, in a field survey on August 25, 1999, do hereby certify that under requirements of P.A. 74, Michigan P.A. of 1970, the corner points mentioned in lines 1 and 2 above were in conformance with regulations and rules therefore as required in the current manual of survey instructions of the United States Department of the Interior, Bureau of Land Management or by a decree of a Court of Law and/or that the corner points mentioned in lines 3, 4 and 5 above were in conformance with the rules of the Michigan Board of Land Surveyors or by a Decree of a Court of Law, established, re-established, monumented, re-monumented, recovered, found as expressed below.

1	A	B	C	D	E	F	G	H	I	J	K	L	M
2	6	5	4	3	2	1							
3													
4	7	8	9	10	11	12							
5													
6	18	17	16	15	14	13							
7													
8	19	20	21	22	23	24							
9													
10	30	29	28	27	26	25							
11													
12	31	32	33	34	35	36							
13													

NOTE: Not more than 2 corners, all in the same town and range, may be recorded on this certificate.

A. Description of original monument and accessories and/or subsequent restoration:

1856 Adair
39.98 Set 1/4 Sec. Post
B. Ash 5" N47W 10
Elm 8" S8E 25

1976 Gourdie-Fraser, (132) 2-238
Set 1 1/2" Well Point (SPM)
Westerly 124.41 Blazed Oak
N85E 30.33 8" Ash
North 12.45 Tree

1990 Roser LCRC #693
Fd Well Point. Drove 1"x 3' Galv.
Pipe W/Alum Cap in Well Point
North 12.36 16" Maple
N85E 30.30 11" Ash
S40E 33.84 11" Swp. Oak
S85W 35.93 13" Maple

1980 Lapham, (132) 2-610
Fd 1 1/2" Well Point
North 12.36 16" Maple
N85E 30.30 11" Ash

1994 Roser, DNR Plan #R-18-AB
Meas. N89-43-40W, 2607.39
Meas. S89-43-39E, 2611.92


APPROVED LAND CORNER
P.A. 345 of 1990
Clare County

Chairman [Signature]
Date 9-15-99

B. Description of corner evidence found and/or method applied in restoring or re-establishing corner:
See dossier for detailed report.
Fd DNR Mon in well point. Fd two 1976 witnesses, and all 1980 and 1990 witnesses.

C. Description of monument for corner and accessories established to perpetuate locating the position of the corner:
Accepted DNR Mon for Clare Co. Remon Monument. Accepted as best available evidence of the accepted position of the corner.
Witnesses:

N04°W 12.45 Set N & T in 18" Maple (OBT)
East 30.30 Fd spike in 12" Ash (OBT)
S34°E 33.84 Fd spike in 14" Oak (OBT)
West 35.93 Fd spike in 14" Maple (OBT)

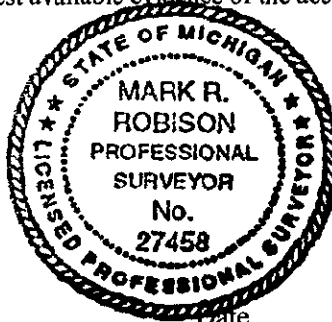

Signed by [Signature]
Surveyor's Michigan License No. 27458

Date 9-15-99