

SURVEY & REMONUMENTATION

JAN 23 2001

SECTION

LAND CORNER RECORDATION CERTIFICATE
Filing Requirement of Act 74, Mich. P.A. 1970
Clare County Remonumentation

For Corners in
Clare

(County)

Located In:

Corner Code#:

- | | | |
|--------------------------------------|----------------------------|------------|
| 1. Public Land Survey | T. <u>20N</u> R. <u>5W</u> | <u>J-9</u> |
| | T. _____ R. _____ | _____ |
| | T. _____ R. _____ | _____ |
| 2. Public Controlling in Section | S. _____ T. _____ R. _____ | _____ |
| | S. _____ T. _____ R. _____ | _____ |
| 3. Miscellaneous Property in Section | S. _____ T. _____ R. _____ | _____ |
| | S. _____ T. _____ R. _____ | _____ |
| 4. Lot No. _____, Recorded Plat | | |
| 5. Private Claims _____ | | |

200000010160
 Filed for Record in
 CLARE COUNTY MICHIGAN
 CAROL MCAULAY
 On 12-15-2000 At 07:44 am.
 LAND CORNER 9.00
 OR Liber 2 Page 283 - 283

Instrument 200000010160 OR Liber Page 2 283

#488-00

Register of Deeds Stamp & File Number

I, Mark R. Robison, in a field survey on November 9, 2000, do hereby certify that under requirements of P.A. 74, Michigan P.A. of 1970, the corner points mentioned in lines 1 and 2 above were in conformance with regulations and rules therefore as required in the current manual of survey instructions of the United States Department of the Interior, Bureau of Land Management or by a decree of a Court of Law and/or that the corner points mentioned in lines 3, 4 and 5 above were in conformance with the rules of the Michigan Board of Land Surveyors or by a Decree of a Court of Law, established, re-established, monumented, re-monumented, recovered, found as expressed below.

NOTE: Not more than 2 corners, all in the same town and range, may be recorded on this certificate.

	A	B	C	D	E	F	G	H	I	J	K	L	M
2	6	5	4	3	2	1							
3													
4	7	8	9	10	11	12							
5													
6	18	17	16	15	14	13							
7													
8	19	20	21	22	23	24							
9													
10	30	29	28	27	26	25							
11													
12	31	32	33	34	35	36							
13													

A. Description of original monument and accessories and/or subsequent restoration:

GLO, Adair, 1856

Set Post

S. Pine 6" N58°E, 22 LINKS

S. Pine 7" S45°W, 12 LINKS

Survey, Roser, 1994, Unrecorded

Same as LCRC #717-92

J-9 to I-9, 2632.29

J-9 to K-9, 2632.29

CSR, Johnson, 1935

Bk 2. Pg. 65

Two witnesses

I-9 to K-9, 79.80 chains

LCRC, Roser, 1992

LCRC #717-92

Set D.N.R Monument by S.P.M.

between I-9 and K-9.

Four witnesses and cedar post

APPROVED LAND CORNER
 P.A. 345 of 1990
 Clare County

Chairman *Paul S. Leppan*

Date 12-13-00

B. Description of corner evidence found and/or method applied in restoring or re-establishing corner.

Found D.N.R. Monument and four 1992 witnesses. Verified distance K-9 by G.P.S. Accepted D.N.R. Monument as being set by single proportionate method and best available evidence

C. Description of monument for corner and accessories established to perpetuate locating the position of the corner:
 Accepted D.N.R. Monument as Clare County Remonumentation Monument.

Witnesses:


N70°W, 31.7' - N & T in 12" x 6" Twin R. Pine (OBT)

N05°E, 36.8' - N & T in 14" R. Pine (OBT)

S50°E, 15.3' - N & T in 15" R. Pine

S83°W, 31.2' - N & T in 12" R. Pine

Signed by *Mark R. Robison*
 Surveyor's Michigan License No. 27458

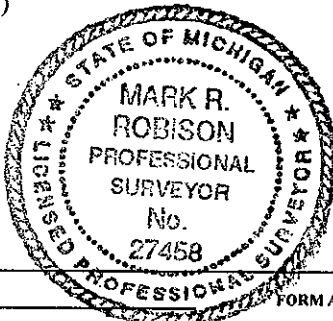

Date 12/14/2000