

**SURVEY &  
REMONUMENTATION**

**MAR 24 2000**

**SECTION**

**LAND CORNER RECORDATION CERTIFICATE**  
**Filing Requirement of Act 74, Mich. P.A. 1970**  
**Clare County Remonumentation**

For Corners in  
Clare

(County)	Located In:	Corner Code#:
1. Public Land Survey	T. <u>20N</u> R. <u>5W</u>	<u>L-7</u>
	T. _____ R. _____	_____
	T. _____ R. _____	_____
2. Public Controlling in Section	S. _____ T. _____ R. _____	_____
	S. _____ T. _____ R. _____	_____
3. Miscellaneous Property in Section	S. _____ T. _____ R. _____	_____
	S. _____ T. _____ R. _____	_____
4. Lot No. _____, Recorded Plat _____		
5. Private Claims _____		

199900007881  
Filed for Record in  
CLARE COUNTY MICHIGAN  
CAROL MCAULAY  
On 09-20-1999 At 11:15 am.  
LAND CORNER 9.00  
OR Liber 2 Page 45 - 45

Instrument 199900007881 OR Liber 2 Page 45

Register of Deeds Stamp & File Number

I, Mark R. Robison, in a field survey on August 12, 1999, do hereby certify that under requirements of P.A. 74, Michigan P.A. of 1970, the corner points mentioned in lines 1 and 2 above were in conformance with regulations and rules therefore as required in the current manual of survey instructions of the United States Department of the Interior, Bureau of Land Management or by a decree of a Court of Law and/or that the corner points mentioned in lines 3, 4 and 5 above were in conformance with the rules of the Michigan Board of Land Surveyors or by a Decree of a Court of Law, established, re-established, monumented, re-monumented, recovered, found as expressed below.

	A	B	C	D	E	F	G	H	I	J	K	L	M
2	6	5	4	3	2	1							
3													
4	7	8	9	10	11	12							
5													
6	18	17	16	15	14	13							
7													
8	19	20	21	22	23	24							
9													
10	30	29	28	27	26	25							
11													
12	31	32	33	34	35	36							
13													

**NOTE: Not more than 2 corners, all in the same town and range, may be recorded on this certificate.**

A. Description of original monument and accessories and/or subsequent restoration:

1856 Adair  
Set 1/4 Sec. Post  
Cedar 12 S50E 17  
B. Ash 10 N20W 33

4-14 Johnson, CSR 2-35  
Oak 8 N58E 54  
Oak 6 S24W 61 1/2

02-92 Roser  
Fd 3" Sq. Ced Post set by Marcus  
Scaaf from USBT'S & Topo  
(For detailed report & dwg. Sec LCRC).  
Set 1" x 96" DNR Mon.  
and Two Ref. Mon.

Ref Mon 1 is  
S89-36' W, 179.38 of L-7 (5/8" x 34" re-rod)  
& Cedar Post. N55W 41.51 26" W. Pine  
N60E 18.64 5" Maple  
South 8.55 4" W. Pine  
Ref Mon 2 is S89° 54' E 69.99' of L-7  
N15°E 14.85 12" Cedar  
S80°E 29.13 5" W. Oak  
S40°E 28.68 2" W. Pine  
Meas. E; 2684.01  
Meas. W; 2608.72

**APPROVED LAND CORNER**  
**P.A. 345 of 1990**  
**Clare County**  
Chairman *Paul A. Leph*  
Date 9-15-99

B. Description of corner evidence found and/or method applied in restoring or re-establishing corner:  
See dossier for detailed report.


Found both DNR reference monuments and observed DNR corner monument in pond of water.

C. Description of monument for corner and accessories established to perpetuate locating the position of the corner:  
Accepted DNR monument as Clare County Remonument. Accepted as perpetuation of the original corner and witnessed reference monuments as follows: Reference Mon. #1. Set Std Clare Co. Cap on DNR rered S89° 36' W, 179.38' from L-7.

Witnesses:  
N55°W, 41.51, Spike in 30" W. Pine (OBT)  
N60°E, 16.84, Spike in 6" Maple (OBT)  
South, 8.55, Spike in 8" W. Pine (OBT)  
References Mon. #2. DNR capped 5/8" x 34" rered S89° 54' E, 69.99' from L-7.

Witnesses:  
N15°E, 14.85', Spike in Cedar (OBT)  
S80°E, 29.13, Spike in W. Oak (OBT)  
S40°E, 26.68, Spike in W. Pine (OBT)  
N40°E, 27.38, Spike in 8" W. Oak

Signed by *Mark R. Robison*  
Surveyor's Michigan License No. 27458

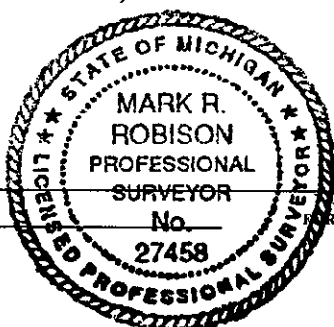

Date 9-15-99