

**SURVEY &
REMONUMENTATION**

JAN 23 2001

SECTION

**LAND CORNER RECORDATION CERTIFICATE
Filing Requirement of Act 74, Mich. P.A. 1970
Clare County Remonumentation**

For Corners in <u>Clare</u> (County)	Located In:	Corner Code#:
1. Public Land Survey	T. <u>20N</u> R. <u>5W</u>	<u>M-9</u> ✓
	T. <u>20N</u> R. <u>4W</u>	<u>A-9</u>
	T. _____ R. _____	_____
2. Public Controlling in Section	S. _____ T. _____ R. _____	_____
	S. _____ T. _____ R. _____	_____
3. Miscellaneous Property in Section	S. _____ T. _____ R. _____	_____
	S. _____ T. _____ R. _____	_____
4. Lot No. _____, Recorded Plat _____		
5. Private Claims _____		

200000010159
Filed for Record in
CLARE COUNTY MICHIGAN
CAROL MCAULAY
On 12-15-2000 At 07:44 am.
LAND CORNER 9.00
OR Liber 2 Page 282 - 282

Instrument Liber Page
200000010159 OR 2 282

487-00

Register of Deeds Stamp & File Number

I, Mark R. Robison, in a field survey on November 28, 2000, hereby certify that under requirements of P.A. 74, Michigan P.A. of 1970, the corner points mentioned in lines 1 and 2 above were in conformance with regulations and rules therefore as required in the current manual of survey instructions of the United States Department of the Interior, Bureau of Land Management or by a decree of a Court of Law and/or that the corner points mentioned in lines 3, 4 and 5 above were in conformance with the rules of the Michigan Board of Land Surveyors or by a Decree of a Court of Law, established, re-established, monumented, re-monumented, recovered, found as expressed below.

	A	B	C	D	E	F	G	H	I	J	K	L	M
1													
2	6	5	4	3	2	1							
3													
4	7	8	9	10	11	12							
5													
6	18	17	16	15	14	13							
7													
8	19	20	21	22	23	24							
9													
10	30	29	28	27	26	25							
11													
12	31	32	33	34	35	36							
13													

NOTE: Not more than 2 corners, all in the same town and range, may be recorded on this certificate.

This is a single corner common to T20N, R5W, & T20N, R4W

A. Description of original monument and accessories and/or subsequent restoration:

GLO, Nicholson, 1839
Set Post - Two witnesses

LCRC, Roser, 1992
LCRC #653-92
Fd 3/4" x 12" iron rod.
Added RLS cap.
Four witnesses and cedar post

GLO, Adair, 1856
Int. Bdy. 18 links.
North of post and corrected.
Two witnesses

Survey, Roser, 1994, Unrecorded DNR Survey
Same as LCRC #653-92
M-9 to M-8 = 2636.09
M-9 to M-10 = 2672.89
M-9 to L-9 = 2712.39

CSR, Johnson, 1914
SR, Bk 2. Pg. 35
M-9 to M-8, 40 125 chains

CSR, Johnson, 1935
CSR Bk 2. Pg. 64
Two witnesses

APPROVED LAND CORNER
P.A. 345 of 1990
Clare County

Chairman *Paul L. Lepke*
Date 12-13-00


B. Description of corner evidence found and/or method applied in restoring or re-establishing corner.

Found 3/4" x 12" iron rod. Verified one 1935 witness and all 1992 witnesses. Verified distance M-9 to L-9 by G.P.S. Accepted 3/4" iron as best available evidence of the position of the corner.

C. Description of monument for corner and accessories established to perpetuate locating the position of the corner:

Set 5/8" x 35" rered with Clare County Remon Cap marked P.S. #27458.
Witnesses:
N22°E, 45.34' - N & T in 32" B. Oak (1935 OBT)
N40°E, 61.83' - N & T in 16" W. Oak (OBT)
S40°E, 65.80' - N & T in Power Pole (OBT)
S35°W, 32.55' - N & T in 14" W. Pine (OBT)

Signed by *Mark R. Robison*
Surveyor's Michigan License No. 27458

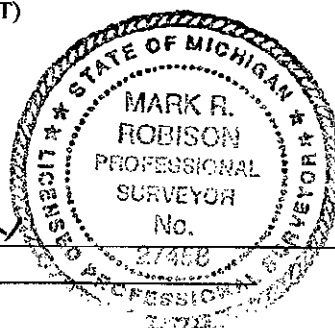

Date 12/14/2000