LAND CORNER RECORDATION CERTIFICATE
Filing Requirement of Act 74, Mich. P.A. 1970

For corners in
CLARE
(County)

	Located In:	Corner Code ##
1. Public Land Survey	T 20N R 5W	K-3, K-4
	T ____ R ____	K-5, L-5
	T ____ R ____	
	T ____ R ____	
2. Property Controlling	S ____ T ____ R ____	
in Section	S ____ T ____ R ____	
3. Miscellaneous	S ____ T ____ R ____	
Property in Sec.	S ____ T ____ R ____	

Register of Deeds Stamp & File Number

4. Lot No. _____ , Recorded Plat _____
5. Private Claims _____

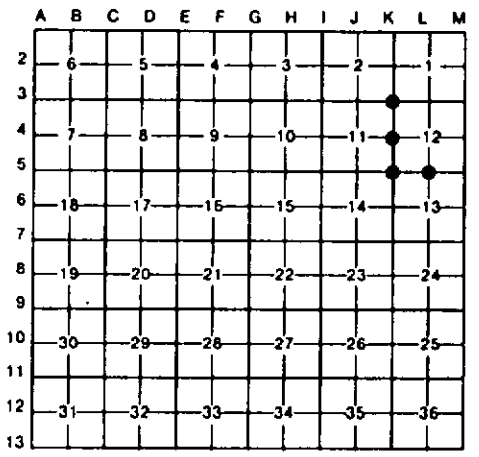

I, CARL F. ROSER, in a field survey on MARCH 28, 19 91, do hereby certify that under requirements of P.A. 74, Michigan P.A. of 1970, the corner points mentioned in lines 1 and 2 above were in conformance with regulations and rules therefore as required in the current manual of survey instructions of the United States Department of the Interior, Bureau of Land Management or by a decree of a Court of Law and/or that the corner points mentioned in lines 3, 4 and 5 above were in conformance with the rules of the Michigan Board of Land Surveyors or by a Decree of a Court of Law; established, re-established, monumented, re-monumented, recovered, found as expressed below:

NOTE: Not more than 4 corners, all in the same town and range, may be recorded on this certificate.

A. Description of original monument and accessories and/or subsequent restoration:

K-3 K-4 K-5 L-5

STATE OF MICHIGAN
CARL F. ROSER
LAND SURVEYOR
No. 12028
REGISTERED LAND SURVEYOR

B. Description of corner evidence found and/or method applied in restoring or reestablishing corner:

K-3
FD M. SCHAAF 2" PIPE FOR NE COR S-11. COR ALSO ACCEPTED & RECORDED BY RLS'S P.LAPHAM & T. MUELLER. COR FALLS NEAR BOTTOM OF STEEP N'LY SLOPE. M. SCHAAF NOTES SAY "FD 2 USBT STPS WITH FACES". WE FD 2-M. SCHAAF NBT STPS THAT FIT CLOSE.

K-4
ACCEPTED 3/4" PIPE FOR E 1/4 COR SEC 11. COR ALSO RECORDED BY LS. T. MUELLER (#25861) IN 1985; & BY LS. P. LAPHAM (#9433) IN 1974 CERT OF SURVEY, Li 1, PG 803. FD REROD W/J. MEYERS, LS CAP #14099. DUE SOUTH 68.95'. CTR OF E-W GRAVEL ROAD IS 38'± 2' SOUTH.

K-5
ACCEPTED 3/4" PIPE FOR NW COR SEC 13. FD 3/4" PIPE ALONGSIDE 2" PIPE BELIEVED TO BE M. SCHAAF'S. COR RECORDED BY OTHERS. COR IN LINE W/ROW OF STEEL FN POSTS N & W.

L-5
FD 1 1/2" PIPE FOR S 1/4 COR SEC 12 AS SET IN 1940 BY DEPT FORESTRY CHIEF & RLS,M.SCHAAF, FROM ON USBT IN PLACE, DEAD, BUT WITH BOTH FACES & SCRIBE MARKS PLAIN (STUB NOW ON GROUND BUT FACE & SCRIBE MARKS STILL VISIBLE). KJ OSTLING FD & RECORDED COR IN 1962 DEPT SUR. FD REMAINS OF 4 M.SCHAAF WITS & 2 K. OSTLING'S WIT STPS THAT FIT FD PIPE.

C. Description of monument for corner and accessories established to perpetuate locating the position of the corner:

K-3
FD 2"X 4.6' LONG PIPE; ADDED CED POST W/ LOC TAG.

11" MAPLE	N35°W	27.42'
5" MAPLE	N50°E	12.73'
#15" MAPLE	S55°E	16.50'
#FD OLD Y PINE STP	S85°W	3.42'
8" MAPLE	S85°W	32.83'

#=LLS PAUL LAPHAM WITS.

K-4
FD 3/4" X 23" PIPE; ADDED DNR MON & SET CED POST.

9" B OAK	N50°W	14.3'
#POWER POLE	N20°E	38.56'
8" J PINE	N80°E	30.60'
#9" J PINE	N80°W	9.40'

#=LLS PAUL LAPHAM WITS.

K-5
FD 3/4" X 4' GALV PIPE; ADDED RLS CAP & SET CED POST W/LOC TAG.

# 9" JACK PINE	N 5°W	35.00'
# 6" JACK PINE	N30°E	21.62'
# 9" JACK PINE	S70°E	23.91'
13" RED PINE	S15°W	115.08'

#=LLS P. LAPHAM WITS.

L-5
FD 1 1/2" PIPE, ADDED DNR MON & SET CED POST.

7" J PINE	N40°W	18.9'
#15" J PINE	N38°W	83.6'
6" J PINE	N 8°W	9.3'
2" J PINE	S25°E	19.6'
3" J PINE	S45°W	15.5'

#=MARCUS SCHAAF 1942 NBT.

Signed by Carl F. Roser 5-22-92 Date _____

Surveyor's Michigan License No. 12028

FORM APPROVED BY MICHIGAN STATE BOARD OF LAND SURVEYORS, JAN. 28, 1971
REVISED MAY 14, 1975
REVISED JAN., 1983