LAND CORNER RECORDATION CERTIFICATE

Filing Requirement of Act 74, Mich. P.A. 1970

For corners in
CLARE
(County)

	Located In:	Corner Code ##
1. Public Land Survey	T 20N R 5W	F-4, G-4
	T ___ R ___	H-4
	T ___ R ___	
	T ___ R ___	
2. Property Controlling	S 10 T ___ R ___	8
in Section	S ___ T ___ R ___	
3. Miscellaneous	S ___ T ___ R ___	
Property in Sec.	S ___ T ___ R ___	

Register of Deeds Stamp & File Number

4. Lot No. _____ , Recorded Plat _____
5. Private Claims _____

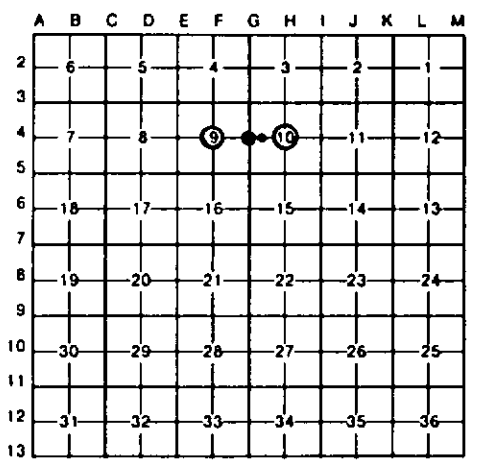

I, CARL F. ROSER, in a field survey on JULY 11, 19 90, do hereby certify that under requirements of P.A. 74, Michigan P.A. of 1970, the corner points mentioned in lines 1 and 2 above were in conformance with regulations and rules therefore as required in the current manual of survey instructions of the United States Department of the Interior, Bureau of Land Management or by a decree of a Court of Law and/or that the corner points mentioned in lines 3, 4 and 5 above were in conformance with the rules of the Michigan Board of Land Surveyors or by a Decree of a Court of Law; established, re-established, monumented, re-monumented, recovered, found as expressed below:

NOTE: Not more than 4 corners, all in the same town and range, may be recorded on this certificate.

A. Description of original monument and accessories and/or subsequent restoration:

F-4 G-4 H-4 8

B. Description of corner evidence found and/or method applied in restoring or reestablishing corner:

F-4
ESTABLISHED CTR OF SEC 9 AT INTERSECTION OF 1/4 LINES. CTR E-W GRAVEL RD IS 50' SOUTH. FD STEEL FN POST. 16'S. AND 2'W (ST FN POST IS ON BRUSHED OUT LINE TO NORTH). ALSO SEE COR RECORD FOR N 1/4 COR; NW COR & W 1/4 COR OF SEC. 9.

G-4
ACCEPTED FD IRON FOR 1/4 COR TO SEC'S 9 & 10. COR FITS PLAT OF "LEOTA RESORT" BY A. JOHNSON (1953±) & WITS BY L.S., M.McCLUNG. COR IS AT INTERSECTION OF GRAVEL ROADS N & W AND B.TOP EAST.

H-4
ESTABLISHED CTR OF SEC 10 AT INTERSECTION OF 1/4 LINES. FD CONC MON (CTR OF S-10 PER W.S. MOORE, PLAT OF "LEOTA RESORT NO 2", 1956) IS S22°50'E. 12.77'. E-W CHAIN LINK FENCE IS 12' SOUTH. NW'LY EDGE OF MUSKEGON RIVER IS 210'± 30'E. COR FALLS IN MOWED LAWN AREA (& DRIVEWAY TURN AROUND).

8
ESTABLISHED SE COR OF W 1/2 OF NW 1/4 OF SEC 10 PER STANDARD BLM INSTRUCTIONS. CTR OF E-W BIT ROAD IS 13' NORTH. FD CONC MON, N17°E, IS SW COR OF LOT 1 OF PLAT OF "LEOTA RESORT" BY A. JOHNSON (1953±).

C. Description of monument for corner and accessories established to perpetuate locating the position of the corner:

F-4
DROVE 5/8" X 34" REROD W/RLS CAP; SET CED POST W/LOC TAG.

9" OAK	N15°E	24.1'
12" R PINE	S25°E	88.7'
11" R PINE	SOUTH	97.6'

G-4
FD SQ HEAD IR;RAISED UP W/ 3/4" X7" BOLT W/1 1/4"X1 1/4" HEAD.

7" R PINE	S50°E	69.1'
11" TW R PINE	S10°E	51.7'
10" OAK	S30°W	48.1'
*SW COR 8"X 8" TEL RISER	N30°E	66.0'
SET CED POST W/ LOC TAG.	SOUTH	33'

*=LLS M. McCLUNG WIT.

H-4
DROVE 5/8" X 34" REROD W/RLS CAP.

FACE 3" SPRUCE	N55°W	34.9'
19" W ASH	N75°E	27.33'
POWER POLE	S35°E	67.42'

8
DR 5/8" X 34" REROD W/RLS CAP. FD 1/2" IR ROD IN

CONC MON	N17°E	51.45'
17" OAK	S30°E	29.01'
10" R PINE	S15°W	42.27'
8" OAK	S35°W	37.24'
SET CED POST W/ LOC TAG.	SOUTH	33'

Signed by Carl F. Roser 5-22-92 Date _____

Surveyor's Michigan License No. 12028

STATE OF MICHIGAN
CARL F. ROSER
AND
SURVEYOR
No. 12028
REGISTERED LAND SURVEYOR

FORM APPROVED BY MICHIGAN STATE BOARD OF LAND SURVEYORS, JAN. 28, 1971
REVISED MAY 14, 1975
REVISED JAN., 1983