

**LAND CORNER RECORDATION CERTIFICATE**  
**Filing Requirement of Act 74, Mich. P.A. 1970**

For corners in  
CLARE  
(County)

Located In: \_\_\_\_\_ Corner Code ~~##~~

- |                                    |   |            |   |           |                 |
|------------------------------------|---|------------|---|-----------|-----------------|
| 1. Public Land Survey              | T | <u>20N</u> | R | <u>5W</u> | <u>A-3, A-5</u> |
|                                    | T | _____      | R | _____     | <u>B-5</u>      |
|                                    | T | _____      | R | _____     | _____           |
|                                    | T | _____      | R | _____     | _____           |
| 2. Property Controlling in Section | S | _____      | T | _____     | R               |
|                                    | S | _____      | T | _____     | R               |
| 3. Miscellaneous Property in Sec.  | S | _____      | T | _____     | R               |
|                                    | S | _____      | T | _____     | R               |

Register of Deeds Stamp & File Number

4. Lot No. \_\_\_\_\_, Recorded Plat \_\_\_\_\_
5. Private Claims \_\_\_\_\_

	A	B	C	D	E	F	G	H	I	J	K	L	M
2	6		5		4		3		2		1		
3													
4	7		8		9		10		11		12		
5													
6	18		17		16		15		14		13		
7													
8	19		20		21		22		23		24		
9													
10	30		29		28		27		26		25		
11													
12	31		32		33		34		35		36		
13													

I, CARL F. ROSER, in a field survey on JULY 27, 19 90, do hereby certify that under requirements of P.A. 74, Michigan P.A. of 1970, the corner points mentioned in lines 1 and 2 above were in conformance with regulations and rules therefore as required in the current manual of survey instructions of the United States Department of the Interior, Bureau of Land Management or by a decree of a Court of Law and/or that the corner points mentioned in lines 3, 4 and 5 above were in conformance with the rules of the Michigan Board of Land Surveyors or by a Decree of a Court of Law; established, re-established, monumented, re-monumented, recovered, found as expressed below:


**NOTE: Not more than 4 corners, all in the same town and range, may be recorded on this certificate.**

A. Description of original monument and accessories and/or subsequent restoration:

- |   |   |   |
|---|---|---|
| <b>A-3</b>  | <b>A-5</b>  | <b>B-5</b>  |
| ACCEPTED 3/4" BOLT FOR NW COR SEC 7. DEPT SURVEYOR K. OSTLING FD & ACCEPTED BOLT FOR COR IN 1976 SURVEY IN SEC'S 1 & 12 (T20N-R6W) SUR PROJ #75-49. BOLT IS IN GRAVEL RD INTERSEC, N-S-W. COR ALSO RECORDED BY L.S., P. LAPHAM IN 1975. | FD 1" PIPE (DNR ALUM CAP 60NE) FOR SW COR SEC 7. K. OSTLING FD 1" PIPE HERE IN 1976 DEPT SUR THAT FIT CONS POWER CO SURVEY OF SEC 12 (T20N-R6W). ALSO FD ANOTHER IR N10°W. 10.4' THAT KJ OSTLING FD, BUT COULD NOT FIND RECORD OF & DID NOT FIT CONS POWER CO SUR OF SEC 12, T20N-R6W, SO KJO DID NOT ACCEPT. INTERSEC OF GRAVEL RDS N-S-E IS 2' SOUTH. | REESTAB'D S 1/4 COR OF SEC 7 AT PROPORTIONATE MEAS TO US (GLD RUN OUT SEC) & ON LINE BETWEEN FD SEC CORS 1/2 MILE E & W. CTR OF 29'± WIDE E-W GRAVEL RD IS 12' NORTH. |

C. Description of monument for corner and accessories established to perpetuate locating the position of the corner:

- |  |  |   |
|--|--|---|
| <b>A-3</b>   | <b>A-5</b>   | <b>B-5</b>  |
| FD BOLT; ADDED 5/8" X 34" REROD W/RLS CAP. CTR GAS WELL#943 N50°W 112.2' 12" R PINE N60°E 41.2' 4" B OAK S55°E 44.1' 8" TN B CHERRY S80°W 103.1' SET CED POST W/ LOC TAG. EAST 33' | FD 1" GALV PIPE W/RIVET; RAISED W/1" X 7" GALV PIPE W/RLS CAP. #16" B OAK N67°W 69.42' 7" B OAK N55°E 60.18' 3" J PINE S30°E 84.79' 8" B OAK S35°W 100.60' SET CED POST W/ LOC TAG WEST 33' *LLS K. OSTLING WIT. | DROVE 5/8" X 34" REROD W/RLS CAP. 18" B OAK (IN CLP) S10°E 45.5' 4" B OAK S20°W 94.5' 8" TN B OAK S70°W 139.7' SET CED POST W/ LOC TAG. NORTH 45' |

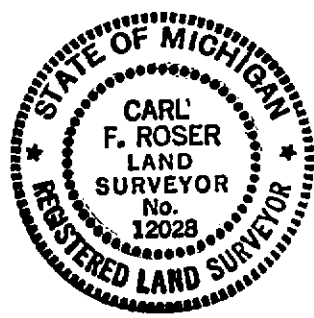

Signed by Carl F. Roser 5-22-92 Date \_\_\_\_\_

Surveyor's Michigan License No. 12028